

GENERAL NOTES

- FOR THE DURATION OF CONSTRUCTION ACTIVITIES, THE 1 GENERAL CONTRACTOR SHALL PRESERVE & PROTECT EXISTING CONDITIONS TO REMAIN AND ENSURE THE BUILDING'S OCCUPANTS MAY SAFELY USE SPACES IN THE AREAS OF THE BUILDING NOT BEING RENOVATED.
- REFER TO 'A400' SERIES DRAWINGS FOR ADDITIONAL INFORMATION REGARDING THE NEW MONUMENTAL STAIR.


01 ADDED SIGN & NOTE
 PROVIDE SIGN TYPE 'S2A' - MOUNT TO WALL
 COORDINATE LOCATION IN FIELD
 REFER TO TECH SPECS FOR MORE INFO

01 ADDED SIGN & NOTE
 PROVIDE SIGN TYPE 'S4' - MOUNT TO WALL
 COORD LOCATION IN FIELD
 REFER TO TECH SPECS FOR MORE INFO

01 INCREASED INNER CMU FROM 8" TO 12"

01 INCREASED INNER CMU FROM 8" TO 12"

SCALE & DIMENSIONS	BASE BIDS
BAR IS ONE (1) INCH LONG ON ORIGINAL DRAWING 0 1 IF BAR IS NOT ONE (1) INCH LONG, ADJUST SCALE ACCORDINGLY. CONTRACTOR SHALL FIELD VERIFY ALL DIMENSIONS. VARIANCE FROM CONTRACT NOT PERMITTED WITHOUT BUREAU OF ENGINEERING AND ARCHITECTURE APPROVAL.	ALL WORK SHOWN ON THIS DRAWING IS INCLUDED IN BASE BID 01, UNLESS NOTED OTHERWISE ON THIS DRAWING. REFER TO PROJECT MANUAL FOR FULL DESCRIPTION OF ALL BASE BIDS.

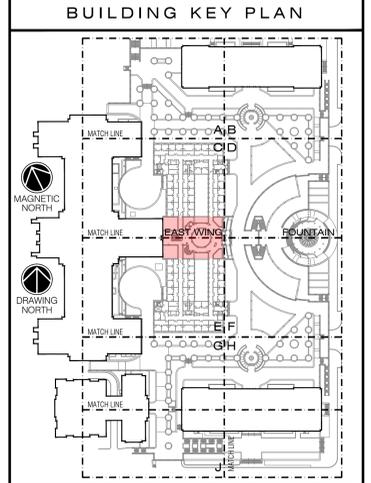

VITETTA PROJECT 4645.0000 © 2024 VITETTA
 ALL DIMENSIONS MUST BE VERIFIED BY THE CONTRACTOR(S) AND THE ARCHITECT NOTIFIED OF ANY DISCREPANCIES BEFORE PROCEEDING WITH THE CONSTRUCTION. DO NOT SCALE THIS DRAWING.

19	20
17	18
15	16
13	14
11	12
09	10
07	08
05	06
03	04
01	02
No.	DESCRIPTION

AS-BUILT REVISIONS

VITETTA Professional's Signature _____ Date 02.12.2024
 Consultant Professional's Signature _____ Date _____

VITETTA
 ARCHITECTURE ENGINEERING PLANNING HISTORIC PRESERVATION
 645 NORTH 12TH STREET • SUITE 100
 LEBANON • PENNSYLVANIA • 17043

COMMONWEALTH OF PENNSYLVANIA
 DEPARTMENT OF GENERAL SERVICES
 HARRISBURG, PENNSYLVANIA

DGS PROJECT NUMBER
C-0948-0101 PHASE 001

CAPITOL EAST WING
 REPLACEMENT OF ESCALATORS WITH ELEVATOR
 HVAC DIFFUSERS & CAFETERIA UPGRADES
 HARRISBURG, DAUPHIN COUNTY, PENNSYLVANIA

**LEVEL 1
 ATRIUM
 ARCHITECTURAL RENOVATION PLAN**

DRAWN BY J. JOLIN	DATE 01-04-2024	DRAWING NUMBER A214Ar
CHECKED BY D. VOSZAK	SCALE 3/8" = 1'-0"	

SCALE
 3/8" = 1'-0"

CONCOURSE LEVEL FLOOR PLAN - ATRIUM - NEW STAIR AND ELEVATOR **01**

DRAWING IS INTENDED FOR COLOR PRINTING

FILEPATH: P:\Projects\4645_00\ARCH\4645_14_A214Ar_Level-1-Atrium_Enlarged_RENO.dwg
 PLOTTED BY: JOLIN
 LAST SAVED: 24.02.13 11:54 AM
 PLOTTED: 24.02.13 12:23 PM