
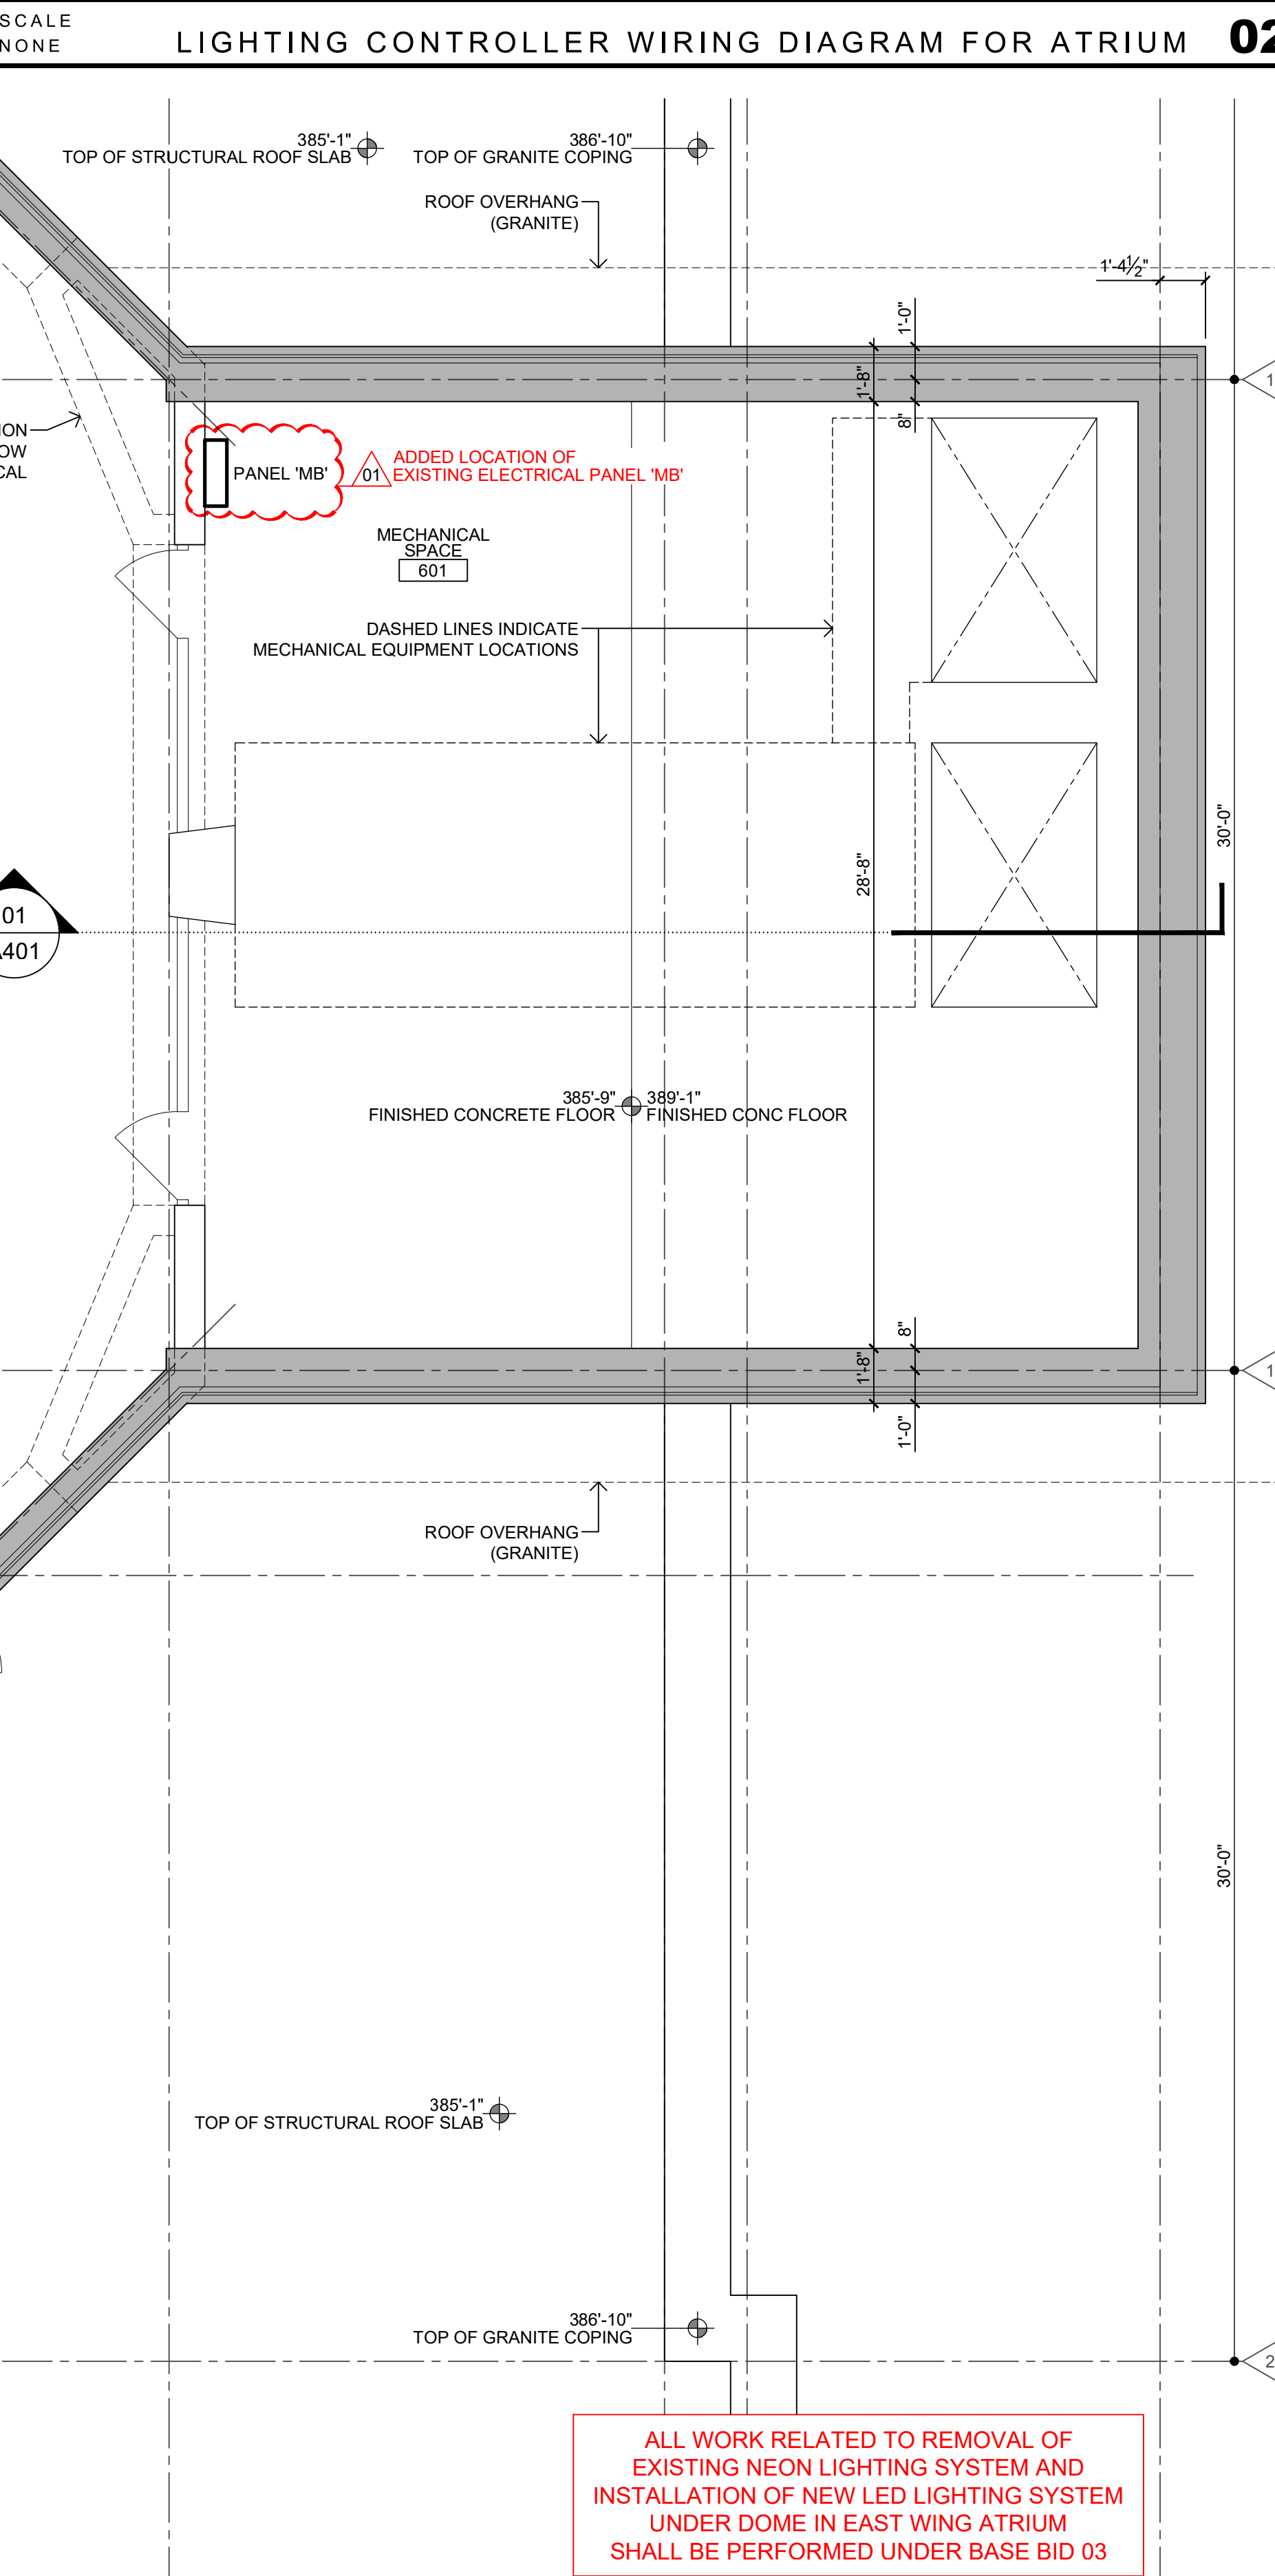
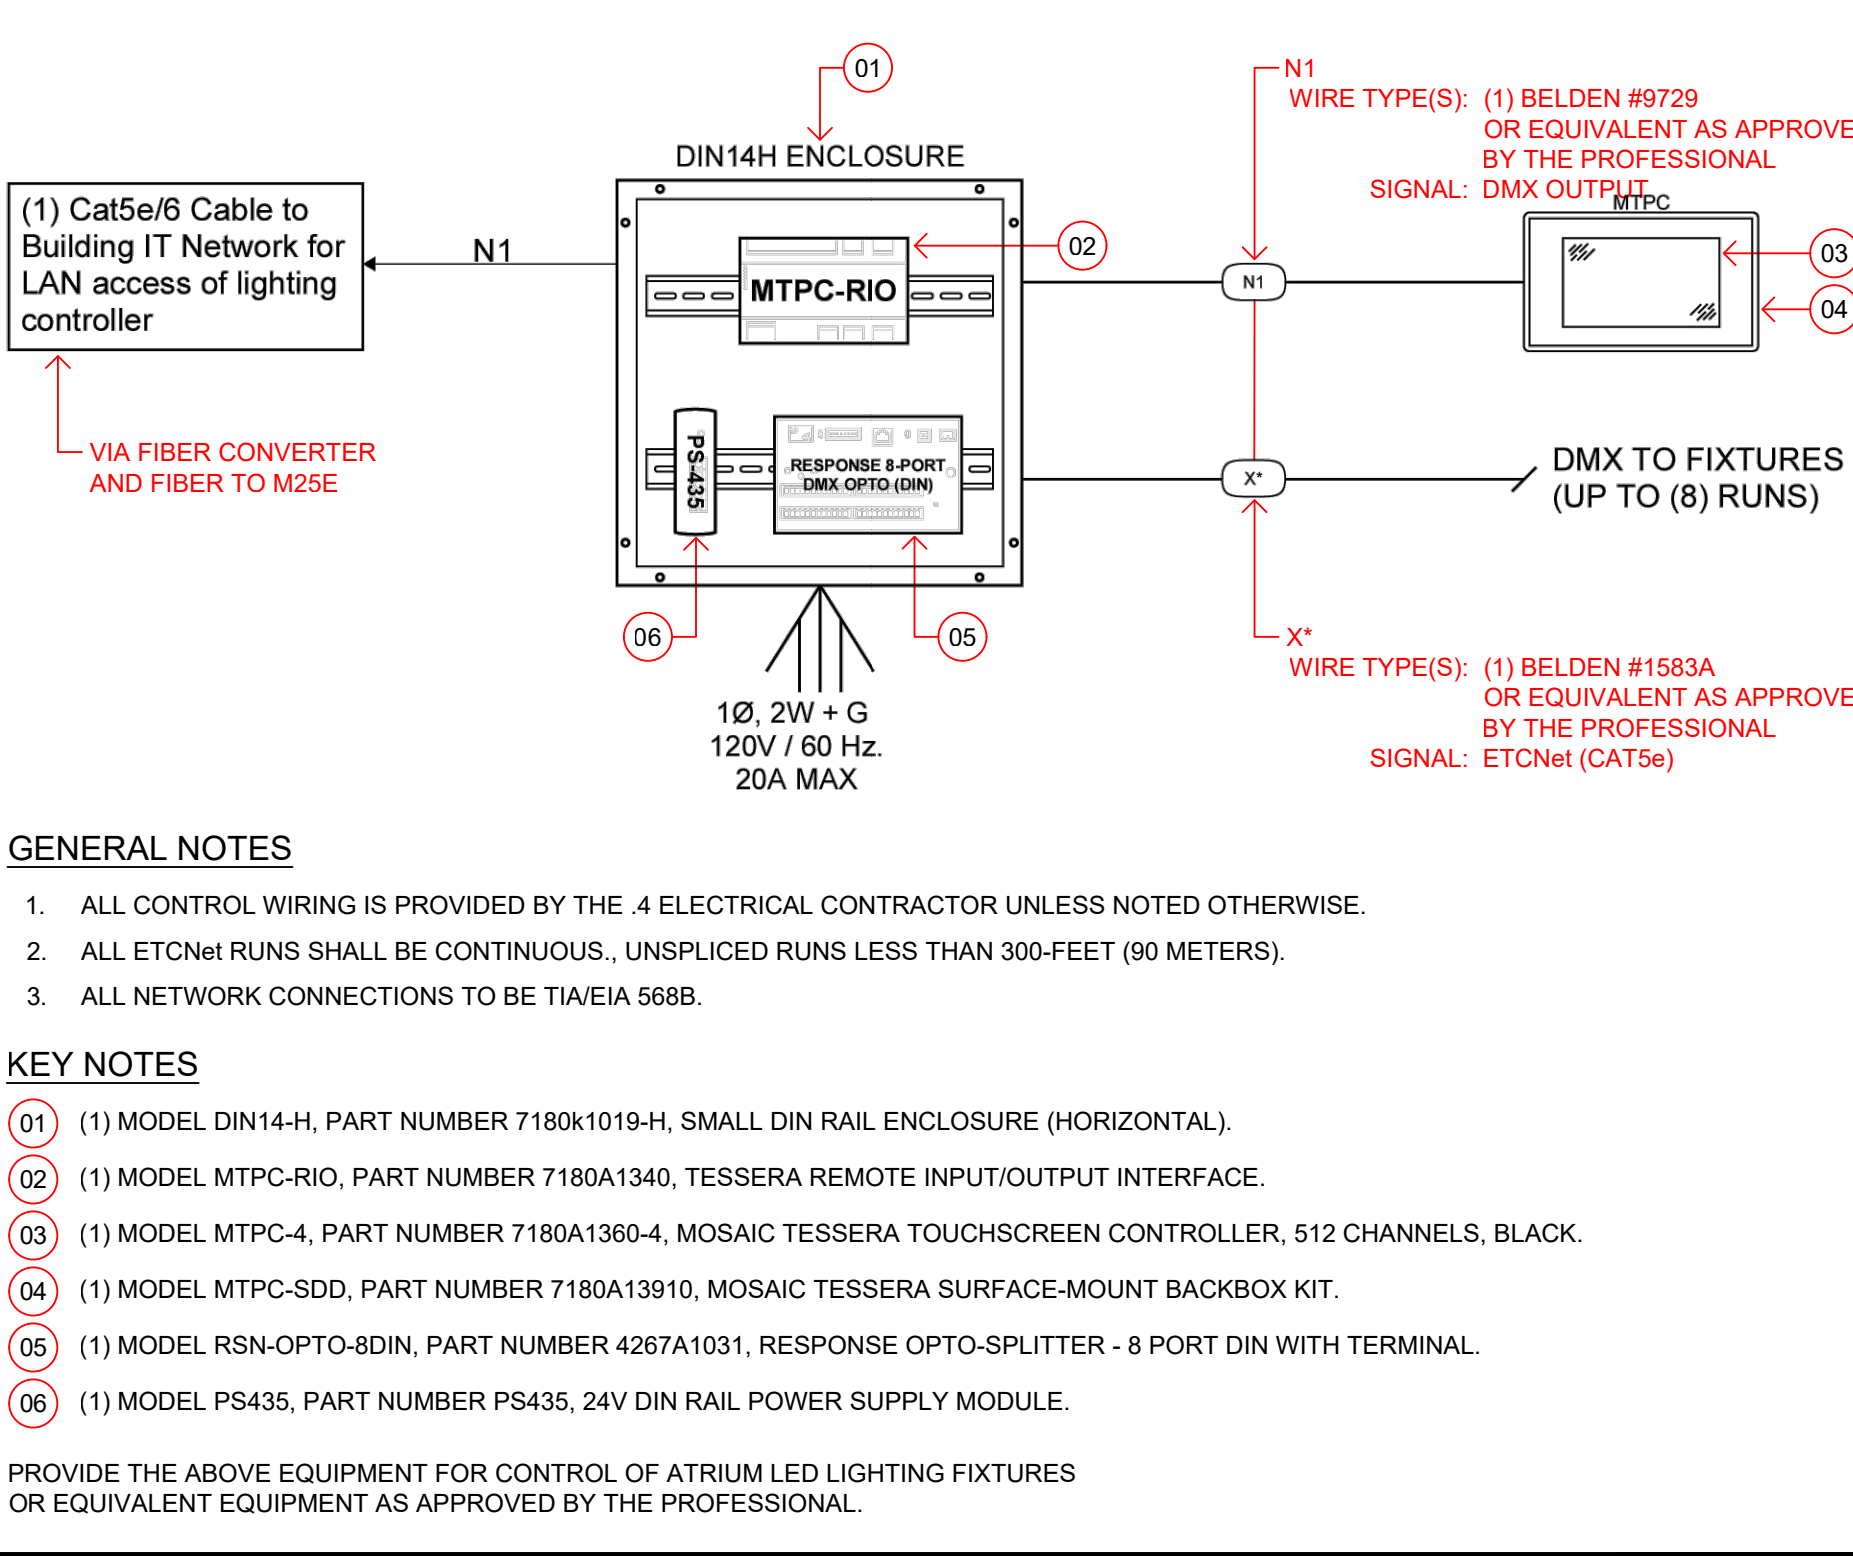
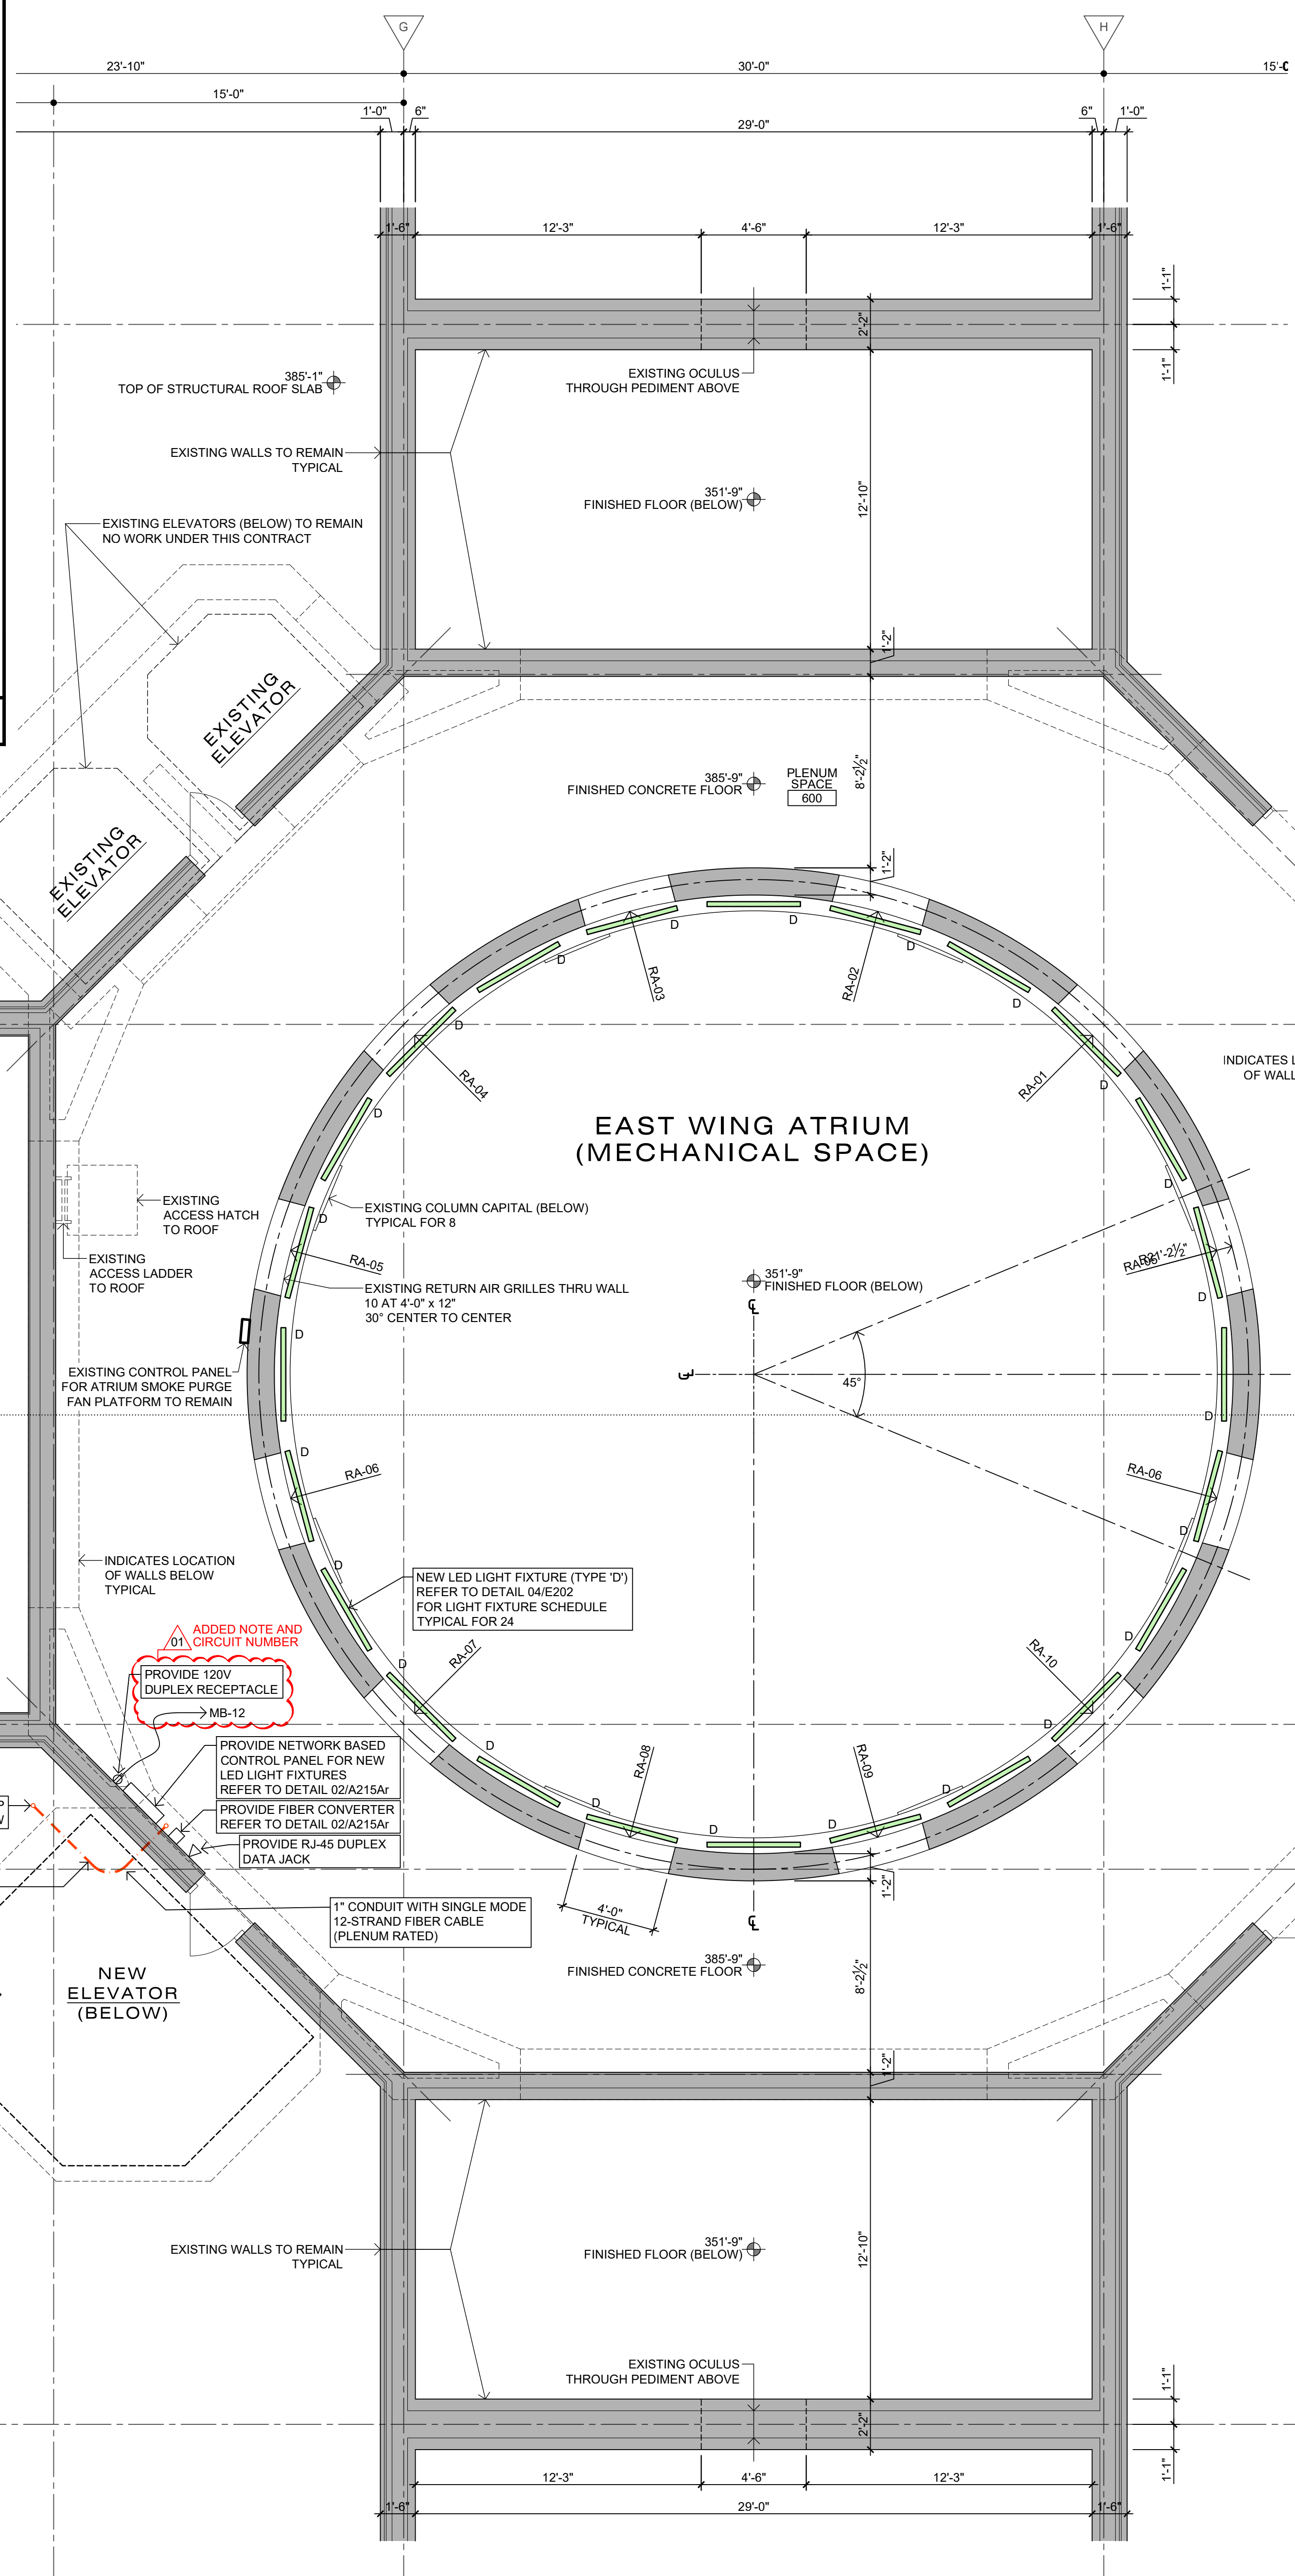



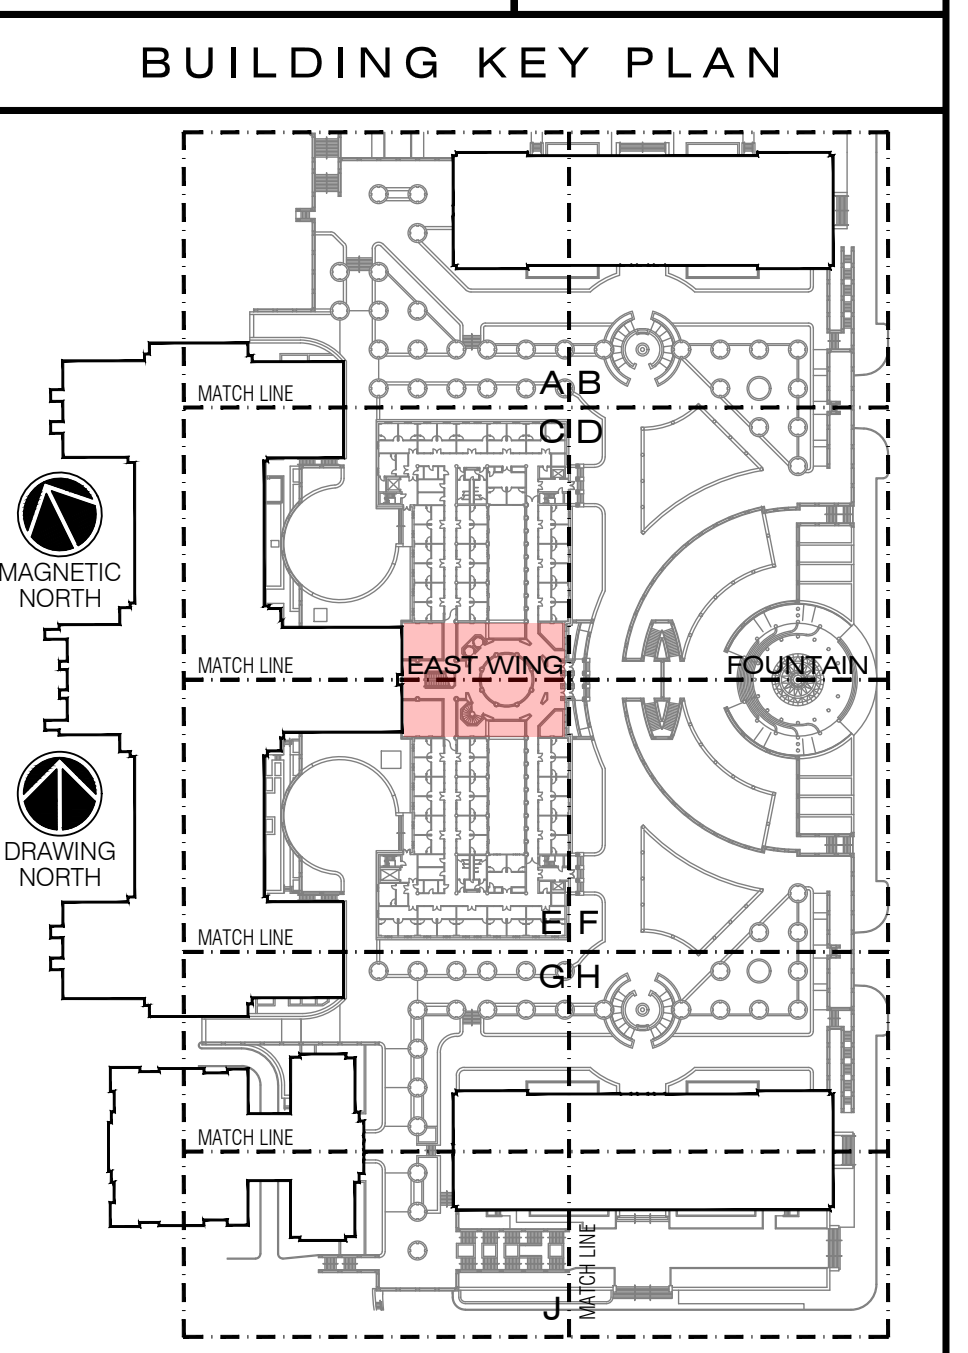
SCALE
NONE

ADDED PANEL SCHEDULE
IN ITS ENTIRETY ELECTRICAL PANEL SCHEDULE

03

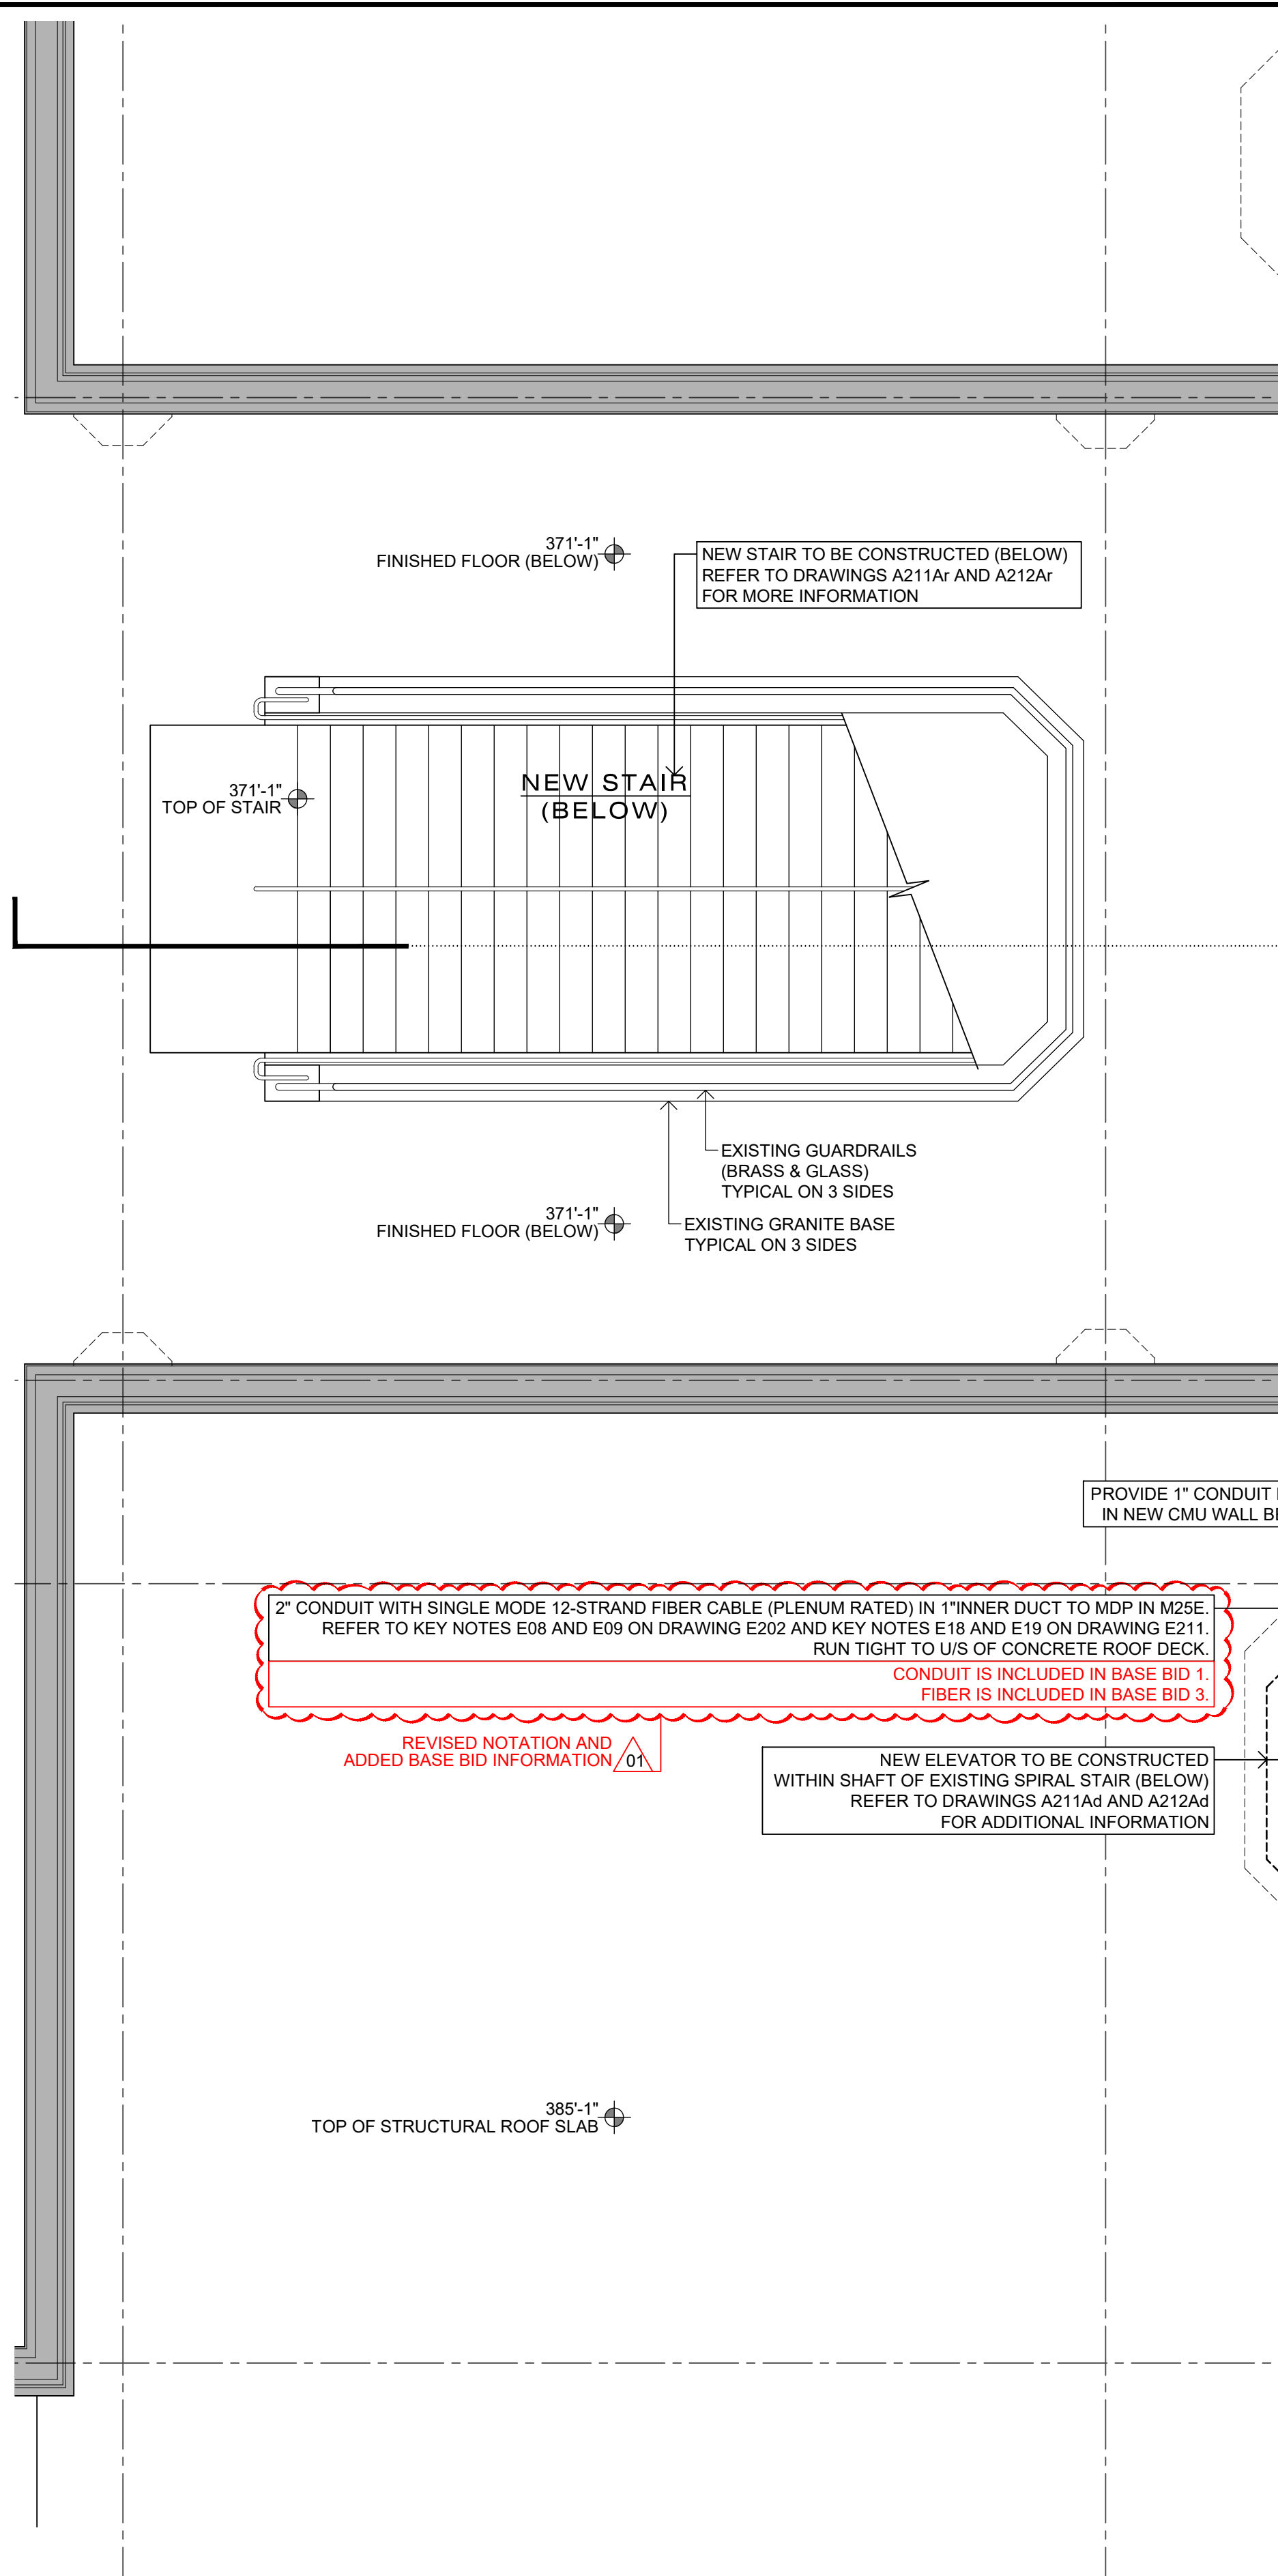

SCALE & DIMENSIONS	BASE BIDS
<p>BAR IS ONE (1) INCH LONG ON ORIGINAL DRAWING</p>  <p>IF BAR IS NOT ONE (1) INCH LONG, ADJUST SCALE ACCORDINGLY. CONTRACTOR SHALL FIELD VERIFY ALL DIMENSIONS. VARIANCE FROM CONTRACT NOT PERMITTED WITHOUT BUREAU OF ENGINEERING AND ARCHITECTURE APPROVAL.</p>	<p>ALL WORK SHOWN ON THIS DRAWING IS INCLUDED IN BASE BID #1, UNLESS NOTED OTHERWISE ON THIS DRAWING.</p> <p>REFER TO PROJECT MANUAL FOR FULL DESCRIPTION OF ALL BASE BIDS.</p>




VITETTA PROJECT 4645.0000

© 2024 VITETTA

ALL DIMENSIONS MUST BE VERIFIED BY THE CONTRACTORS AND THE ARCHITECT NOTIFIED OF ANY DISCREPANCIES BEFORE PROCEEDING WITH THE CONSTRUCTION

DO NOT SCALE THIS DRAWING

19		20	
17		18	
15		16	
13		14	
11		12	
09		10	
07		08	
05		06	
03		04	
01	ADDENDUM 02 / 02.12.2024		
No.	DESCRIPTION	No.	DESCRIPTION
AS-BUILT REVISIONS			

		02.12.2024	
VITETTA Professional's Signature		Consultant Professional's Signature Date	
CONSULTANT VITETTA ARCHITECTURE ENGINEERING PLANNING HISTORIC PRESERVATION 645 NORTH 42 ND STREET • SUITE 100 LEMOYNE • PENNSYLVANIA • 17045			
COMMONWEALTH OF PENNSYLVANIA DEPARTMENT OF GENERAL SERVICES HARRISBURG, PENNSYLVANIA			
DGS PROJECT NUMBER C-0948-0101 PHASE 001			
CAPITOL EAST WING REPLACEMENT OF ESCALATORS WITH ELEVATOR HVAC DIFFUSERS & CAFETERIA UPGRADES HARRISBURG, DAUPHIN COUNTY, PENNSYLVANIA			
MECHANICAL SPACE ATRIUM ELECTRICAL RENOVATION PLAN			
DRAWN BY	DATE	SET DESIGNER	DRAWING NUMBER