




SCALE NONE NOT USED **06**

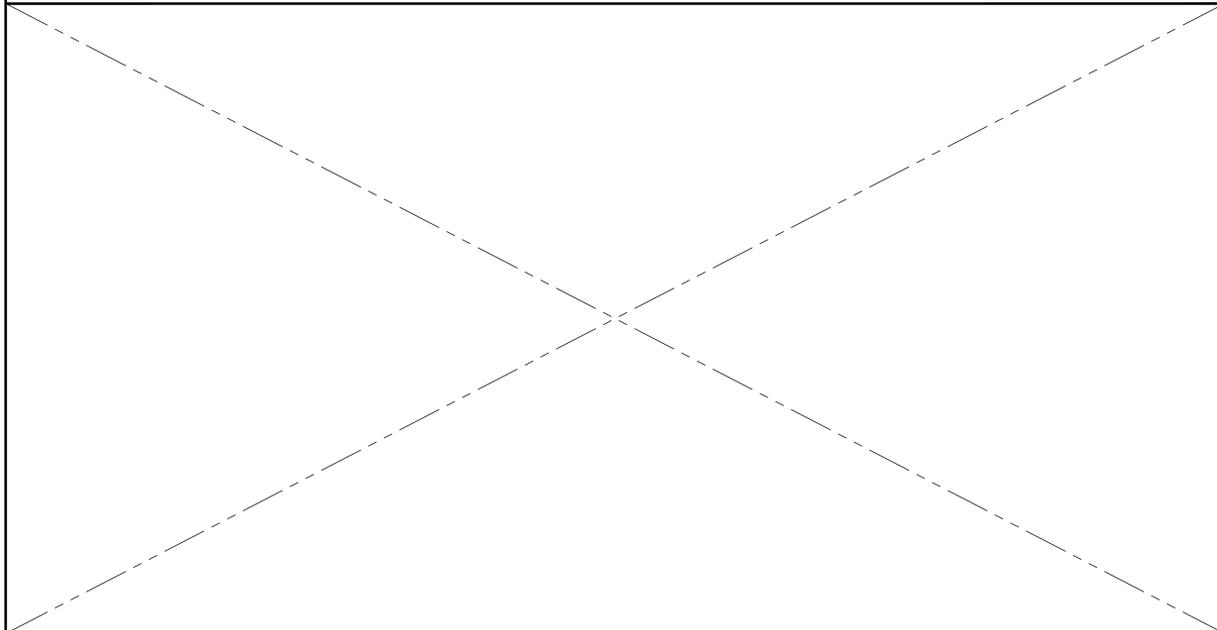


SCALE NONE NOT USED **05**

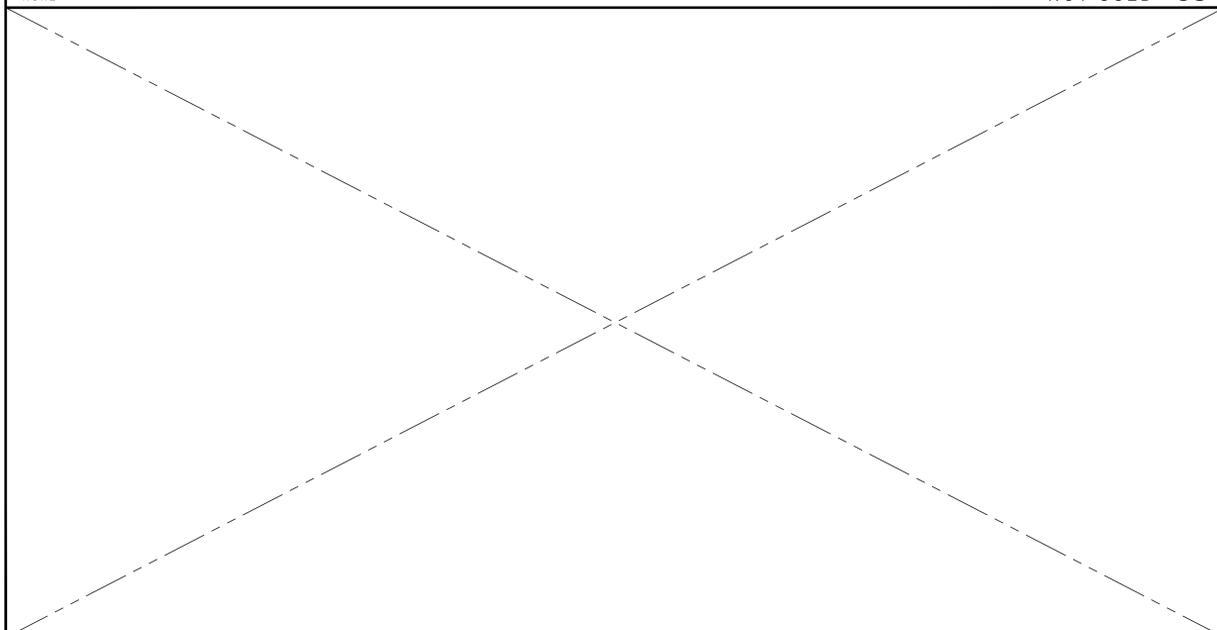


SCALE NONE NOT USED **04**

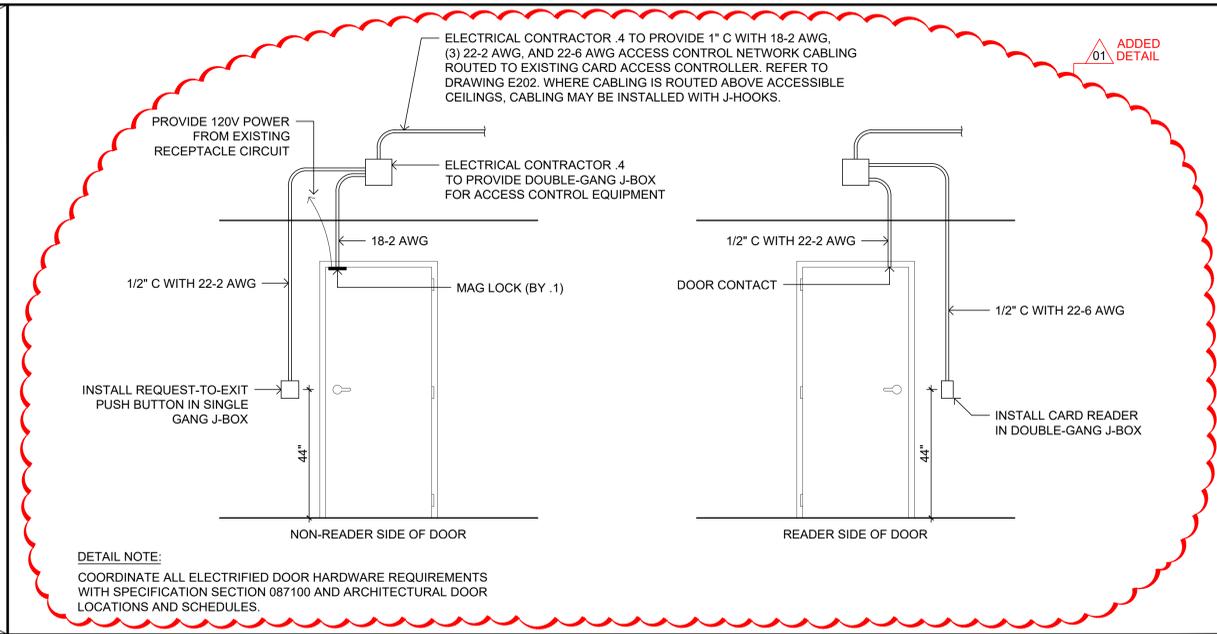

SCALE NONE SINGLE DOOR MAGNETIC LOCK **03**

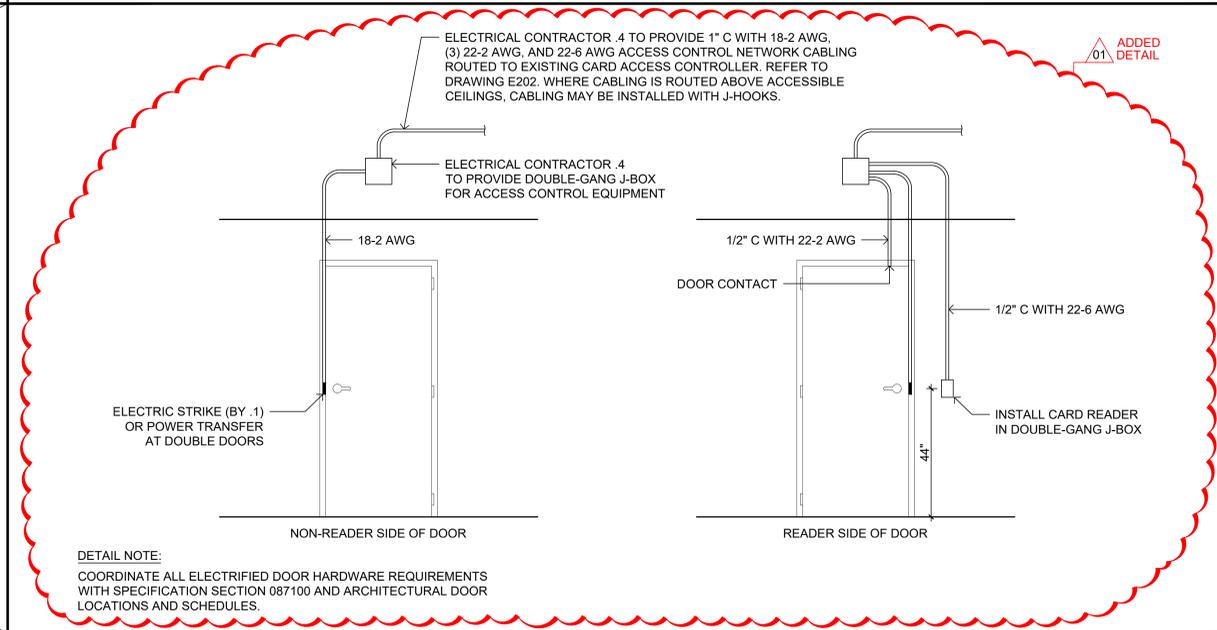

SCALE NONE SINGLE DOOR ELECTRIC STRIKE **02**

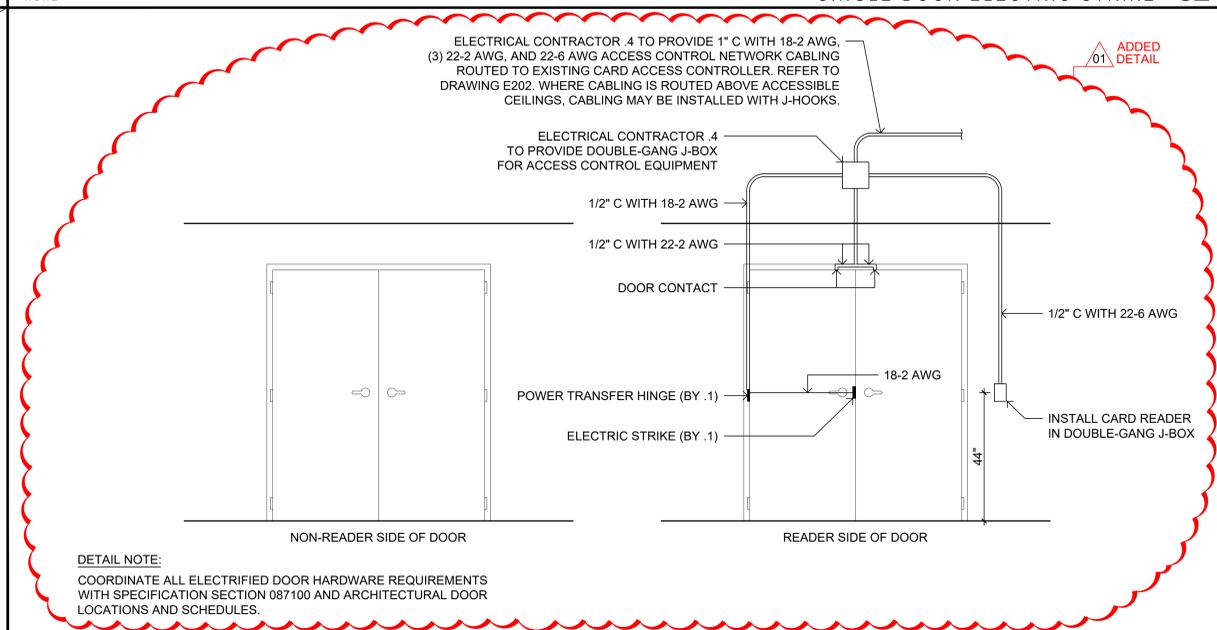

SCALE NONE DOUBLE DOOR ELECTRIC STRIKE **01**

SCALE & DIMENSIONS	BASE BIDS
BAR IS ONE (1) INCH LONG ON ORIGINAL DRAWING 0 1	ALL WORK SHOWN ON THIS DRAWING IS INCLUDED IN BASE BID 01, UNLESS NOTED OTHERWISE ON THIS DRAWING. REFER TO PROJECT MANUAL FOR FULL DESCRIPTION OF ALL BASE BIDS.

No.	DESCRIPTION	No.	DESCRIPTION
19		20	
17		18	
15		16	
13		14	
11		12	
09		10	
07		08	
05		06	
03		04	
01	ADDENDUM 02 02.12.2024	02	

VITETTA PROJECT 4645.0000 © 2024 VITETTA
 ALL DIMENSIONS MUST BE VERIFIED BY THE CONTRACTOR(S) AND THE ARCHITECT NOTIFIED OF ANY DISCREPANCIES BEFORE PROCEEDING WITH THE CONSTRUCTION. DO NOT SCALE THIS DRAWING.

AS-BUILT REVISIONS	
No.	DESCRIPTION

VITETTA Professional's Signature: _____ Date: 02.12.2024
 Consultant Professional's Signature: _____ Date: _____

VITETTA
 ARCHITECTURE | ENGINEERING | PLANNING
 645 NORTH 12TH STREET • SUITE 100
 LEMOYNE • PENNSYLVANIA • 17043

COMMONWEALTH OF PENNSYLVANIA
 DEPARTMENT OF GENERAL SERVICES
 HARRISBURG, PENNSYLVANIA

DGS PROJECT NUMBER
C-0948-0101 PHASE 001
 CAPITOL EAST WING
 REPLACEMENT OF ESCALATORS WITH ELEVATOR
 HVAC DIFFUSERS & CAFETERIA UPGRADES
 HARRISBURG, DAUPHIN COUNTY, PENNSYLVANIA

ELECTRICAL DETAILS

DRAWN BY R. CLOSE	DATE 01.04.2024	DRAWING NUMBER E401
CHECKED BY D. VOZDZAK	SCALE AS NOTED	

DRAWING IS INTENDED FOR COLOR PRINTING

FILE PATH: P:\Projects\4645_00\ELECTRICAL\E401_Electrical_Details.dwg
 PLOTTED BY: CLOSE
 LAST SAVED: 24.02.09.09:58 AM
 PLOTTED: 24.02.19.12:26 PM