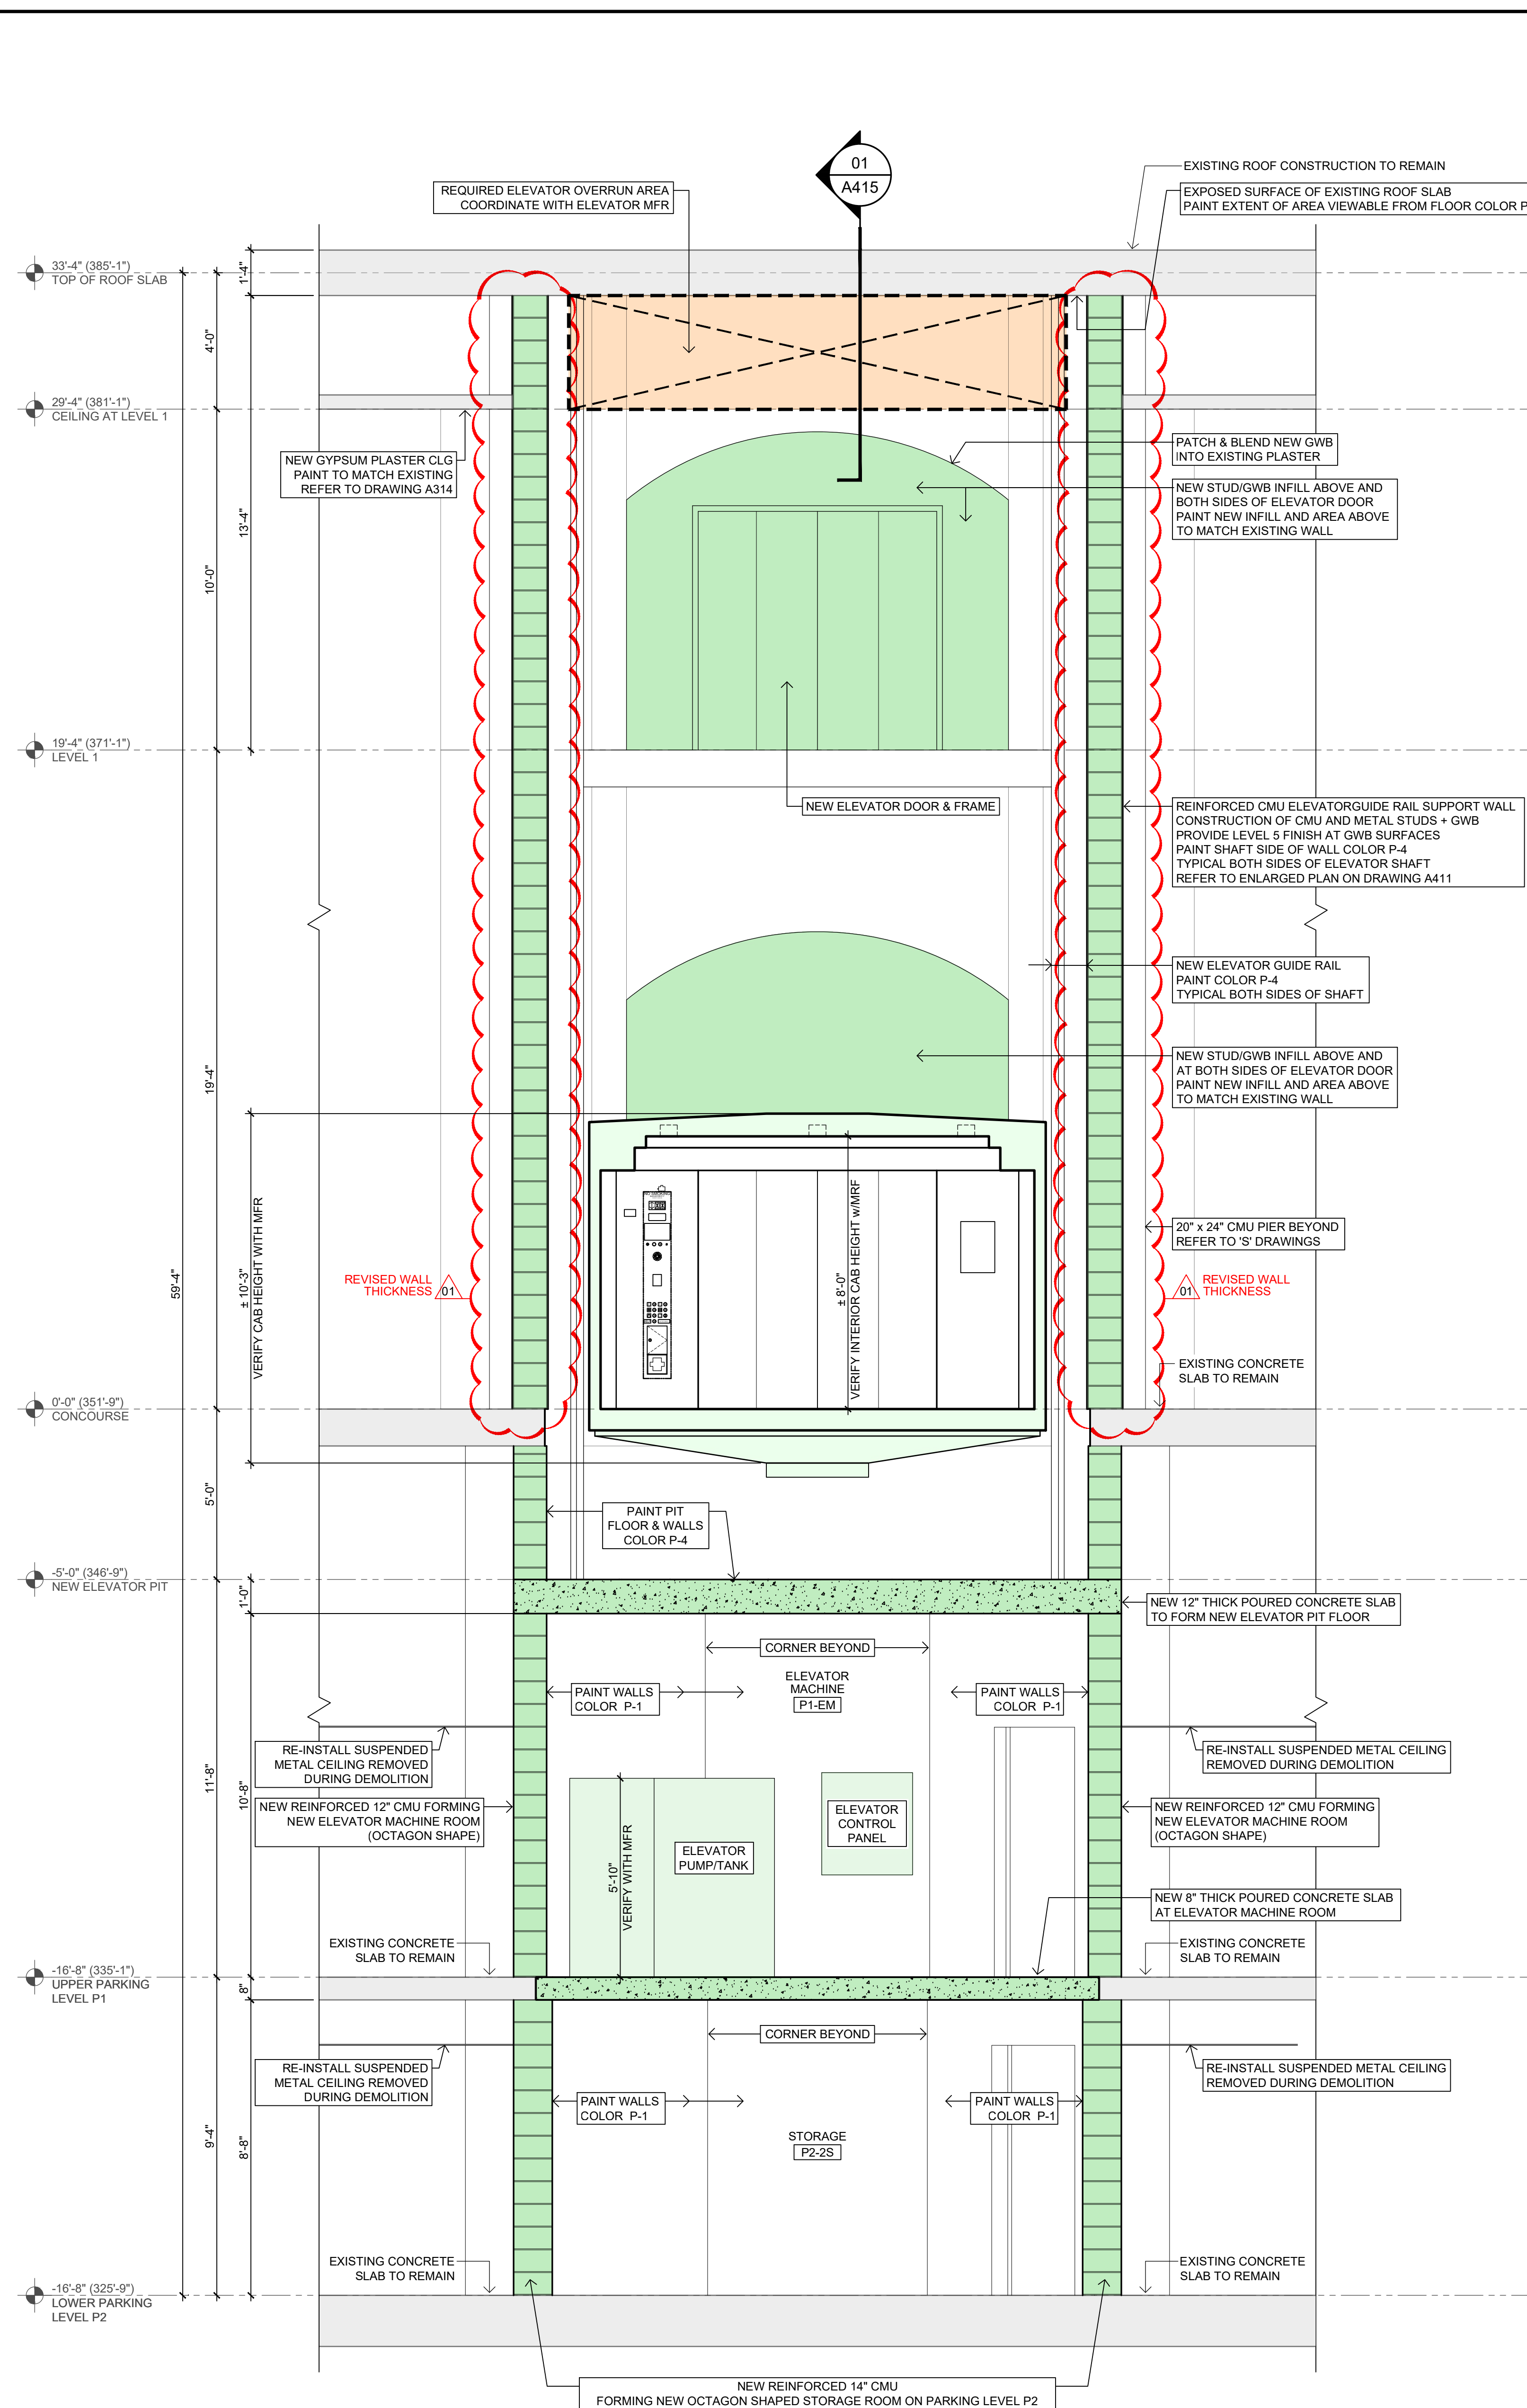


SCALE
3" = 1'-0"

SLAB INFILL AT ELEVATOR HOISTWAY ENTRANCES **04**

SCALE
3/8" = 1'-0"

SCALE
3/8" = 1'-0" CORE 6 - SECTION THROUGH NEW PASSENGER ELEVATOR (FRONT-TO-BACK) - RENOVATION WORK 03

SCALE & DIMENSIONS

BAR IS ONE (1) INCH LONG
ON ORIGINAL DRAWING

0 | 1


IF BAR IS NOT ONE (1) INCH LONG,
ADJUST SCALE ACCORDINGLY.
CONTRACTOR SHALL FIELD VERIFY
ALL DIMENSIONS. VARIANCE FROM
CONTRACT NOT PERMITTED
WITHOUT BUREAU OF ENGINEERING
AND ARCHITECTURE APPROVAL

BASE BIDS

ALL WORK SHOWN
ON THIS DRAWING
IS INCLUDED IN BASE BID 01,
UNLESS NOTED OTHERWISE
ON THIS DRAWING.

REFER TO PROJECT MANUAL
FOR FULL DESCRIPTION
OF ALL BASE BIDS.

BUILDING KEY PLAN

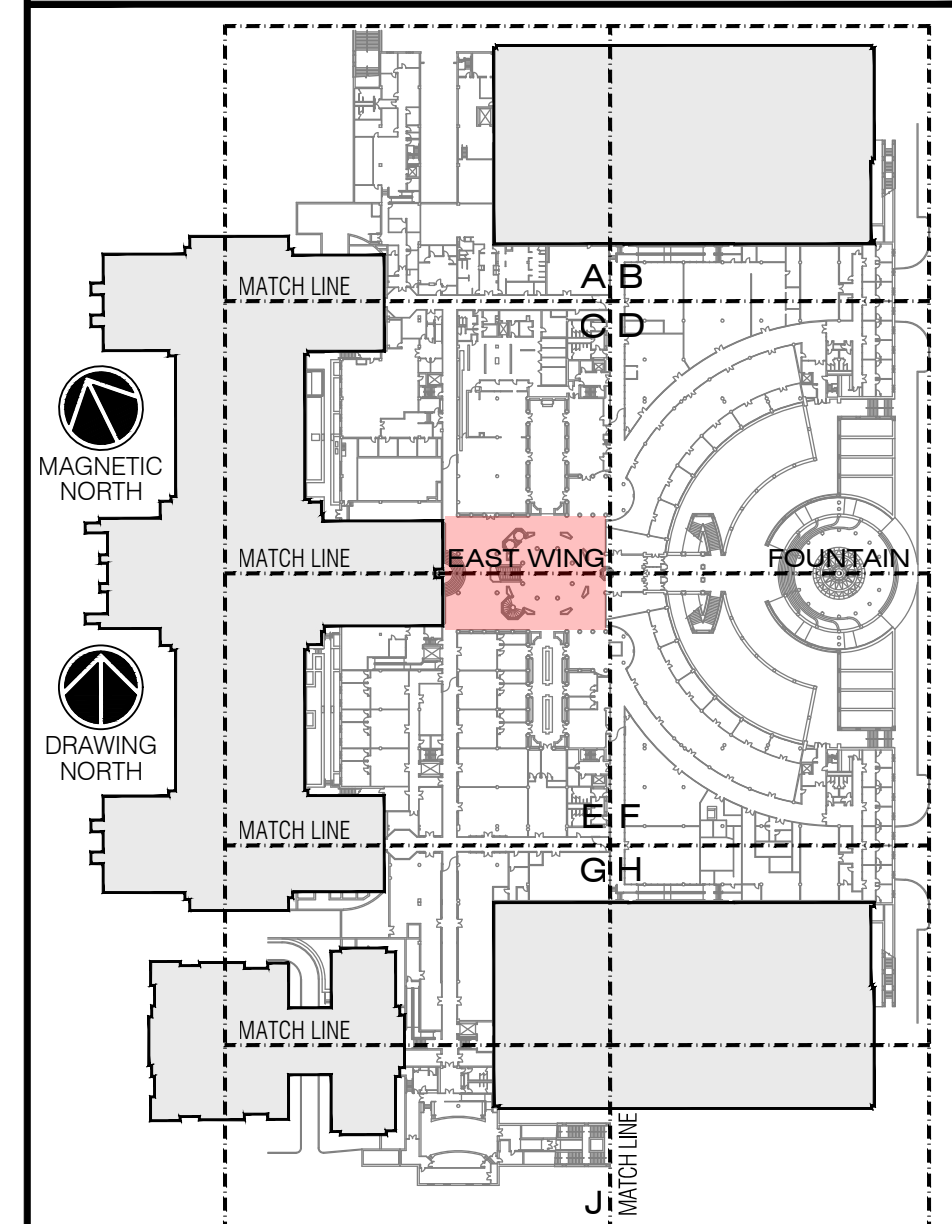


GENERAL NOTE

1. EXISTING CONDITIONS SHOWN ARE BASED UPON THE ORIGINAL CONSTRUCTION DRAWINGS FOR THE EAST WING PREPARED BY CFA/HFL IN 1984 AS WELL AS FIELD SURVEYS BY THE PROFESSIONAL. HOWEVER, ACTUAL CONDITIONS IN THE FIELD MAY VARY, ESPECIALLY THOSE WHICH ARE CONCEALED FROM VIEW.
2. CONTRACTORS SHALL FIELD VERIFY ALL EXISTING CONDITIONS BEFORE PROCEEDING WITH ANY DEMOLITION OR RENOVATION WORK.
3. REFER TO A200 SERIES FLOOR PLAN DRAWINGS FOR INFORMATION COVERING THE CONVERSION OF THE SPIRAL STAIR INTO AN ELEVATOR.
4. ALL EXISTING SPIRAL STAIR COMPONENTS (CONCRETE SUPPORT COLUMN, TREAD SUPPORTS, TREADS, HANDRAILS, ETC.) SHALL BE REMOVED, INCLUDING THOSE NOT SHOWN ON THIS DRAWING.
5. ALL EXISTING METAL & GLASS GUARDRAILS SHALL BE SALVAGED FOR RE-INSTALLATION.
6. REFER TO STRUCTURAL DRAWINGS FOR WALL REINFORCEMENT, SLAB DETAILS, ETC.

VITETTA PROJECT 4645.0000 © 2024 VITETTA

19		20	
17		18	
15		16	
13		14	
11		12	
09		10	
07		08	
05		06	
03		04	
01	APPENDIX 02 02.12.2024	02	

AS-BUILT REVISIONS

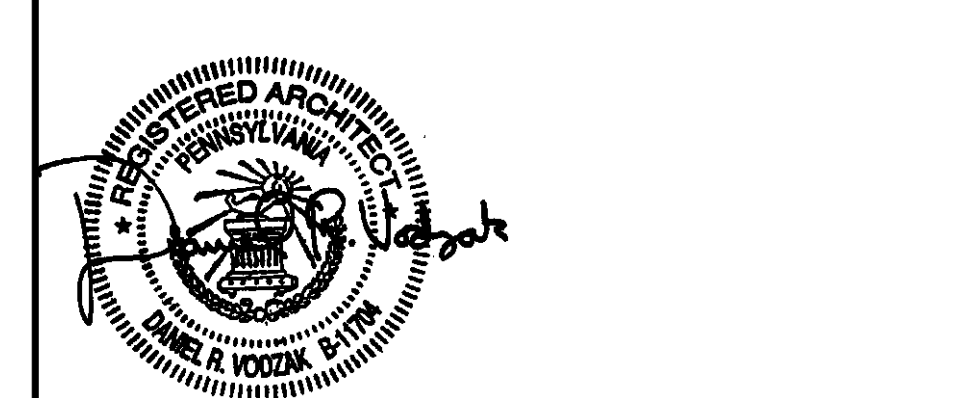

02.12.2024
 VITETTA Professional's Signature _____ Consultant Professional's Signature _____ Date _____

CONSULTANT
VITETTA
ARCHITECTURE | ENGINEERING | PLANNING
HISTORIC PRESERVATION
645 NORTH 12TH STREET • SUITE 100

COMMONWEALTH OF PENNSYLVANIA
DEPARTMENT OF GENERAL SERVICES
HARRISBURG, PENNSYLVANIA

DGS PROJECT NUMBER
C-0948-0101 PHASE 001

CAPITOL EAST WING
REPLACEMENT OF ESCALATORS WITH ELEVATOR
HVAC DIFFUSERS & CAFETERIA UPGRADES

HARRISBURG, DAUPHIN COUNTY, PENNSYLVANIA

NEW PASSENGER ELEVATOR
LATERAL SECTION
RENOVATION WORK

DRAWN BY R. CLOSE/J. JOLIN	DATE BID SET ISSUED 01.01.2004	DRAWING NUMBER
-------------------------------	--------------------------------------	----------------

CHECKED BY	SCALE	A416
D. MORDZAK	1/4" = 1' 0"	

D. VOJZAR	1/4 - 1/6	
-----------	-----------	--

DRAWING IS INTENDED FOR COLOR PRINTING