

**SCALE & DIMENSIONS**  
 BAR IS ONE (1) INCH LONG ON ORIGINAL DRAWING  
 IF BAR IS NOT ONE (1) INCH LONG, ADJUST SCALE ACCORDINGLY. CONTRACTOR SHALL FIELD VERIFY ALL DIMENSIONS. VARIANCE FROM CONTRACT NOT PERMITTED WITHOUT BUREAU OF ENGINEERING AND ARCHITECTURE APPROVAL.


**BASE BIDS**  
 ALL WORK SHOWN ON THIS DRAWING IS INCLUDED IN BASE BID 01, UNLESS NOTED OTHERWISE ON THIS DRAWING.  
 REFER TO PROJECT MANUAL FOR FULL DESCRIPTION OF ALL BASE BIDS.

**GENERAL NOTES FOR NEW STAIR**

- DO NOT SCALE DRAWING A401 DIAGRAM OF ESCALATOR & STAIR IN EACH WING ATRIUM (LOOKING NORTH). REFER TO THE OTHER DRAWINGS THE IN A400 SERIES FOR DIMENSIONS.
- REFER TO DETAIL 01/A402 FOR LONGITUDINAL SECTION THROUGH NEW MONUMENTAL STAIR.
- REFER TO DETAIL 01/A403 FOR ELEVATION OF SOUTH SIDE OF NEW MONUMENTAL STAIR.
- REFER TO DETAIL 02/A403 FOR ELEVATION OF NORTH SIDE OF NEW MONUMENTAL STAIR.
- REFER TO DRAWINGS A404 & A405 FOR LARGE SCALE DETAILS RELATED TO MONUMENTAL STAIR

SCALE 1/2" = 1'-0"  
**GRANITE PAVER LAYOUT FOR INTERMETIATE LANDING AT MONUMENTAL STAIR 03**

SCALE 1/2" = 1'-0"  
**ELEVATION OF WEST END OF ARCHIVES STORAGE BELOW NEW MONUMENTAL STAIR 02**

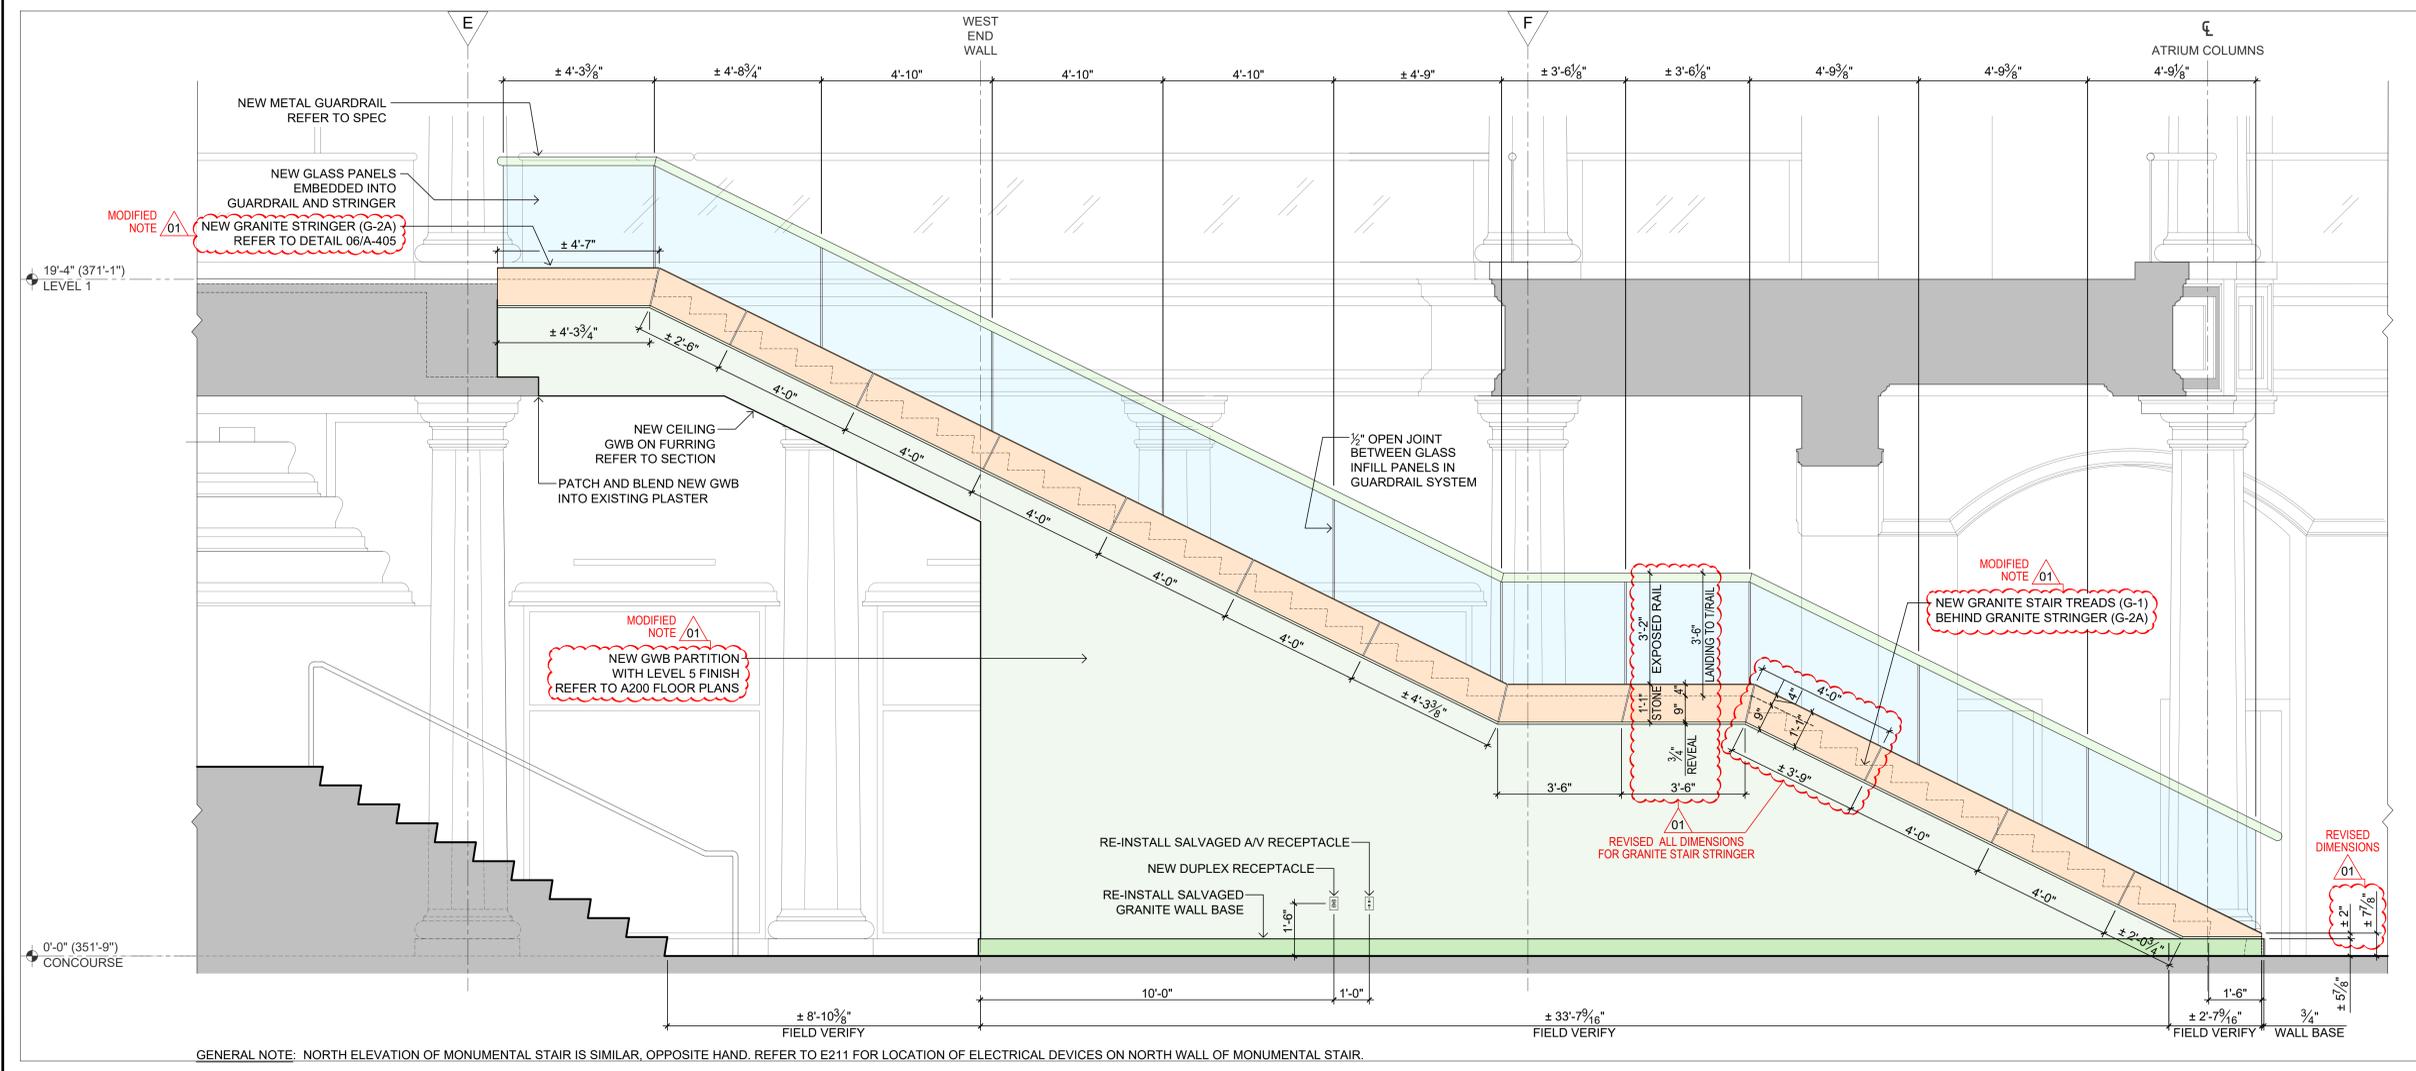

VITETTA PROJECT 4645.0000 © 2024 VITETTA  
 ALL DIMENSIONS MUST BE VERIFIED BY THE CONTRACTOR AND THE ARCHITECT NOTIFIED OF ANY DISCREPANCIES BEFORE PROCEEDING WITH THE CONSTRUCTION. DO NOT SCALE THIS DRAWING.

19	20
17	18
15	16
13	14
11	12
09	10
07	08
05	06
03	04
01	02

ADDENDUM 02 | 02.12.2024

No.	DESCRIPTION	No.	DESCRIPTION
<b>AS-BUILT REVISIONS</b>			

VITETTA Professional's Signature: \_\_\_\_\_ Date: 02.12.2024  
 Consultant Professional's Signature: \_\_\_\_\_ Date: \_\_\_\_\_

**CONSULTANT**  
**VITETTA**  
 ARCHITECTURE | ENGINEERING | PLANNING  
 HISTORIC PRESERVATION  
 645 NORTH 12<sup>TH</sup> STREET • SUITE 100  
 LEMOYNE • PENNSYLVANIA • 17043

**COMMONWEALTH OF PENNSYLVANIA**  
**DEPARTMENT OF GENERAL SERVICES**  
 HARRISBURG, PENNSYLVANIA

DGS PROJECT NUMBER  
**C-0948-0101 PHASE 001**

**CAPITOL EAST WING**  
**REPLACEMENT OF ESCALATORS WITH ELEVATOR**  
**HVAC DIFFUSERS & CAFETERIA UPGRADES**  
 HARRISBURG, DAUPHIN COUNTY, PENNSYLVANIA

**NEW MONUMENTAL STAIR**  
**ELEVATIONS OF SOUTH & NORTH SIDES**  
**INTERMEDIATE LANDING PAVER LAYOUT**

DRAWN BY J. JOLIN	DATE 01.04.2024	DRAWING NUMBER <b>A403</b>
CHECKED BY D. VOZDZAK	SCALE 1/2" = 1'-0", U.N.C.	

SCALE 1/2" = 1'-0"  
**ELEVATION OF THE SOUTH SIDE OF THE NEW MONUMENTAL STAIR 01**

**DRAWING IS INTENDED FOR COLOR PRINTING**

FILEPATH: P:\Projects\4645\_00\ARCH\4645\_20\_A403\_Stair\_Elevations.dwg  
 PLOTTED BY: JOLIN  
 PLOTTED: 24.02.19 12:18 PM  
 LAST SAVED: 24.02.19 06:27 PM