




SCALE 3" = 1'-0" INTERMEDIATE LANDING - WEST END ABUTTING UPPER RISERS 01

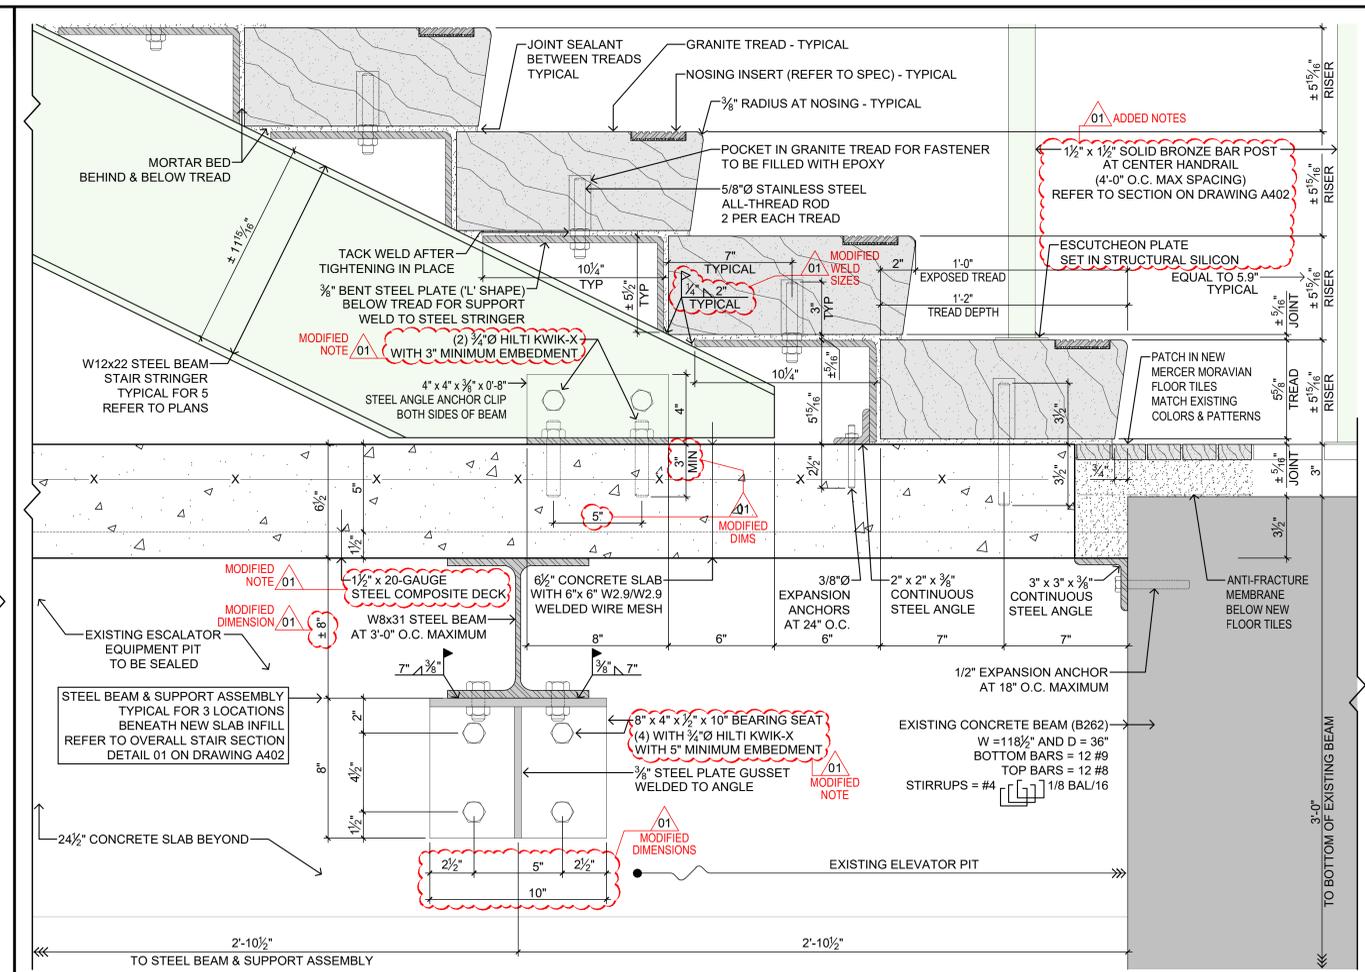

SCALE 3" = 1'-0" BOTTOM LANDING / BOTTOM OF MONUMENTAL STAIR 02

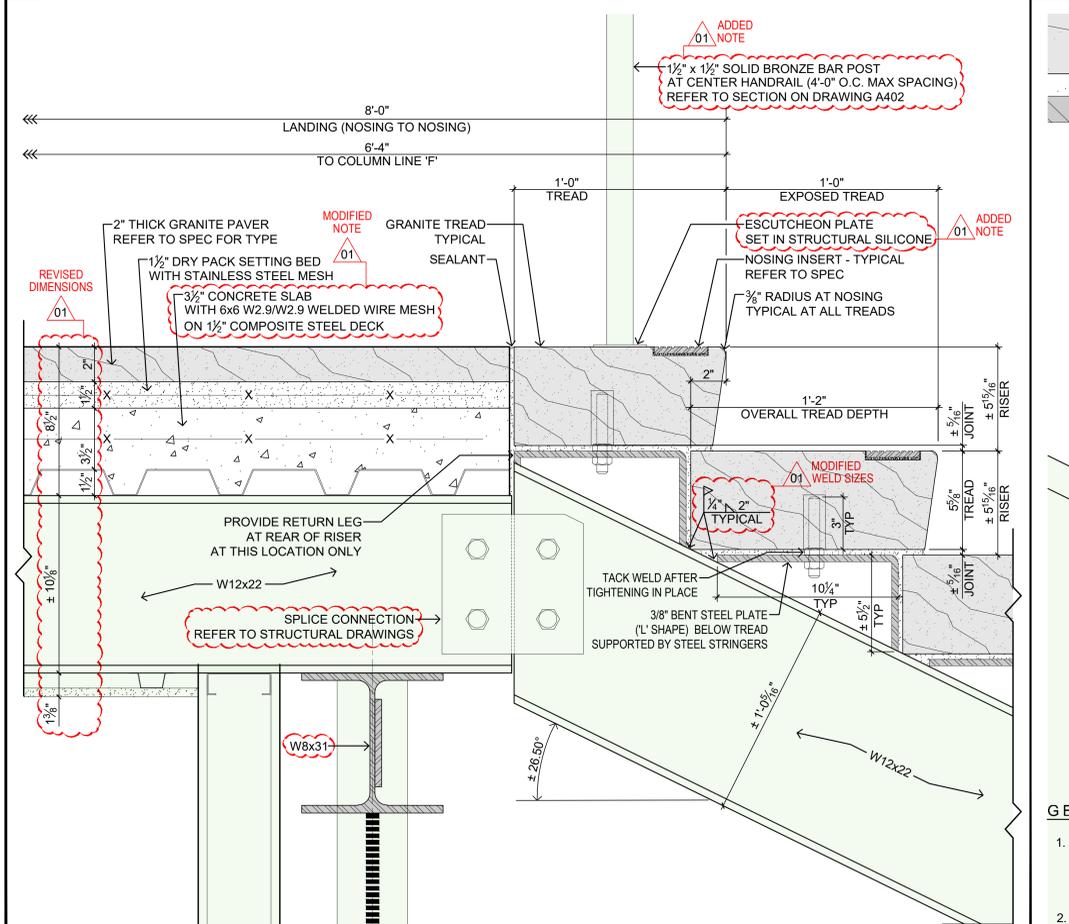

SCALE 3" = 1'-0" INTERMEDIATE LANDING - EAST END ABUTTING LOWER RISERS 03

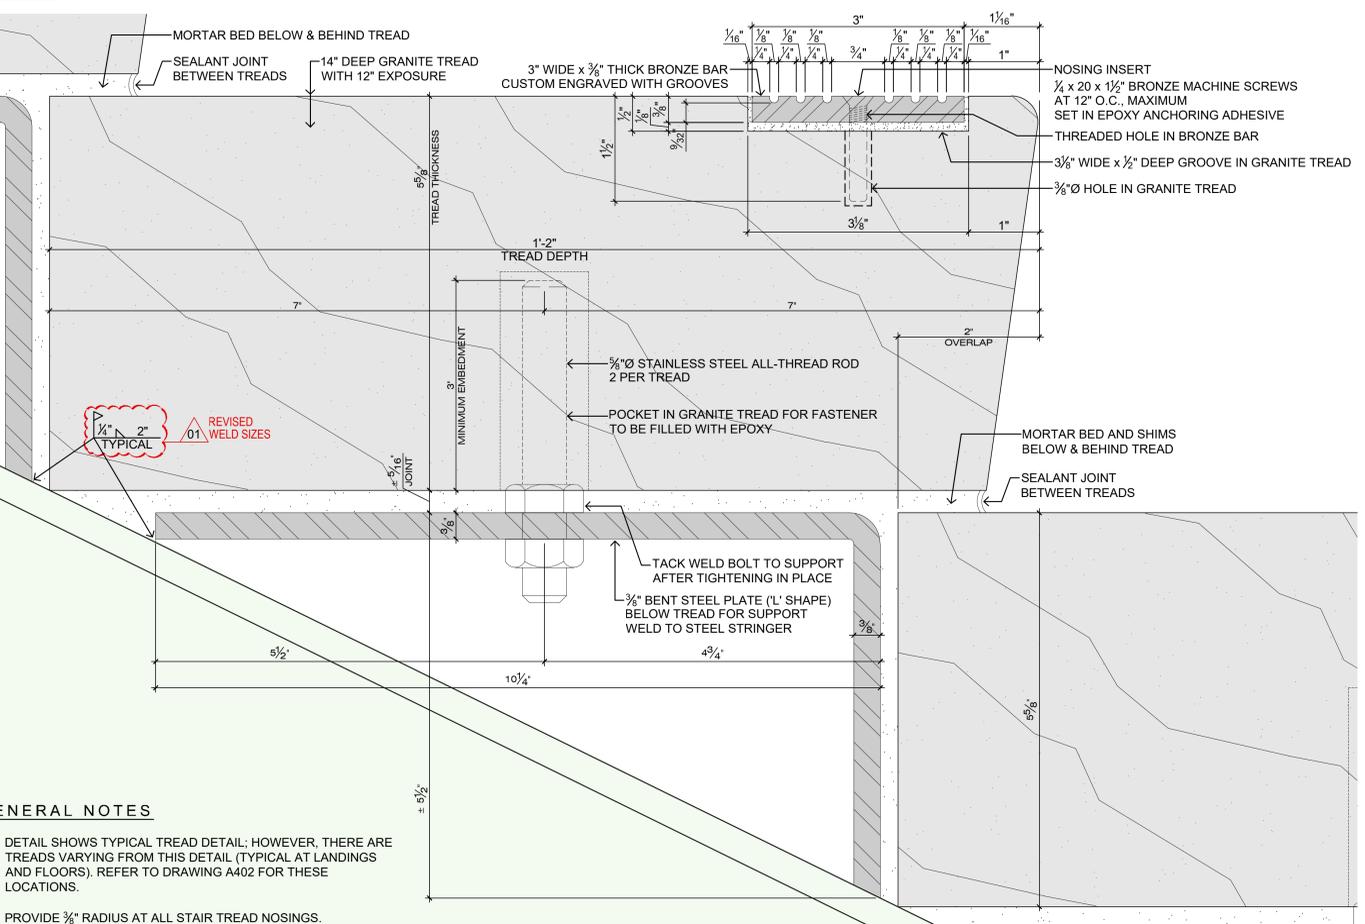

SCALE 1" = 1'-0" TYPICAL TREAD & SUPPORT 04

SCALE & DIMENSIONS	BASE BIDS
BAR IS ONE (1) INCH LONG ON ORIGINAL DRAWING	ALL WORK SHOWN ON THIS DRAWING IS INCLUDED IN BASE BID 01, UNLESS NOTED OTHERWISE ON THIS DRAWING.
IF BAR IS NOT ONE (1) INCH LONG, ADJUST SCALE ACCORDINGLY. CONTRACTOR SHALL FIELD VERIFY ALL DIMENSIONS. VARIANCE FROM CONTRACT NOT PERMITTED WITHOUT BUREAU OF ENGINEERING AND ARCHITECTURE APPROVAL.	REFER TO PROJECT MANUAL FOR FULL DESCRIPTION OF ALL BASE BIDS.

GENERAL NOTES FOR NEW STAIR

- DO NOT SCALE DRAWING A401 DIAGRAM OF ESCALATOR & STAIR IN EACH WING ATRIUM (LOOKING NORTH). REFER TO THE OTHER DRAWINGS THE IN A400 SERIES FOR DIMENSIONS.
- REFER TO DETAIL 01/A402 FOR LONGITUDINAL SECTION THROUGH NEW MONUMENTAL STAIR.
- REFER TO DETAIL 01/A403 FOR ELEVATION OF SOUTH SIDE OF NEW MONUMENTAL STAIR.
- REFER TO DETAIL 02/A403 FOR ELEVATION OF NORTH SIDE OF NEW MONUMENTAL STAIR.
- REFER TO DRAWINGS A404 & A405 FOR LARGE SCALE DETAILS RELATED TO MONUMENTAL STAIR

VITETTA PROJECT 4645 0000  
 ALL DIMENSIONS MUST BE VERIFIED BY THE CONTRACTOR AND THE ARCHITECT NOTIFIED OF ANY DISCREPANCIES BEFORE PROCEEDING WITH THE CONSTRUCTION.  
 © 2024 VITETTA

No.	DESCRIPTION	No.	DESCRIPTION
19		20	
17		18	
15		16	
13		14	
11		12	
09		10	
07		08	
05		06	
03		04	
01	ADDENDUM 02   02.12.2024	02	

AS-BUILT REVISIONS



VITETTA Professional's Signature  
 Consultant's Signature Date  
 CONSULTANT  
**VITETTA**  
 ARCHITECTURE | ENGINEERING | PLANNING  
 645 NORTH 12<sup>TH</sup> STREET • SUITE 100  
 LEBANON • PENNSYLVANIA • 17043

COMMONWEALTH OF PENNSYLVANIA  
 DEPARTMENT OF GENERAL SERVICES  
 HARRISBURG, PENNSYLVANIA

DGS PROJECT NUMBER  
**C-0948-0101 PHASE 001**  
 CAPITOL EAST WING  
 REPLACEMENT OF ESCALATORS WITH ELEVATOR  
 HVAC DIFFUSERS & CAFETERIA UPGRADES  
 HARRISBURG, DAUPHIN COUNTY, PENNSYLVANIA

NEW MONUMENTAL STAIR  
 DETAILS  
 SHEET 1 OF 2

DRAWN BY	DATE	DRAWING NUMBER
J. JOLIN	BID SET ISSUED 01.04.2024	<b>A404</b>
CHECKED BY	SCALE	AS NOTED
D. VOZDZAK		