



SCALE: 1/4" = 1'-0"

PARTIAL FOUNDATION PLAN STORAGE ROOM (FL_EL325'-9") 01

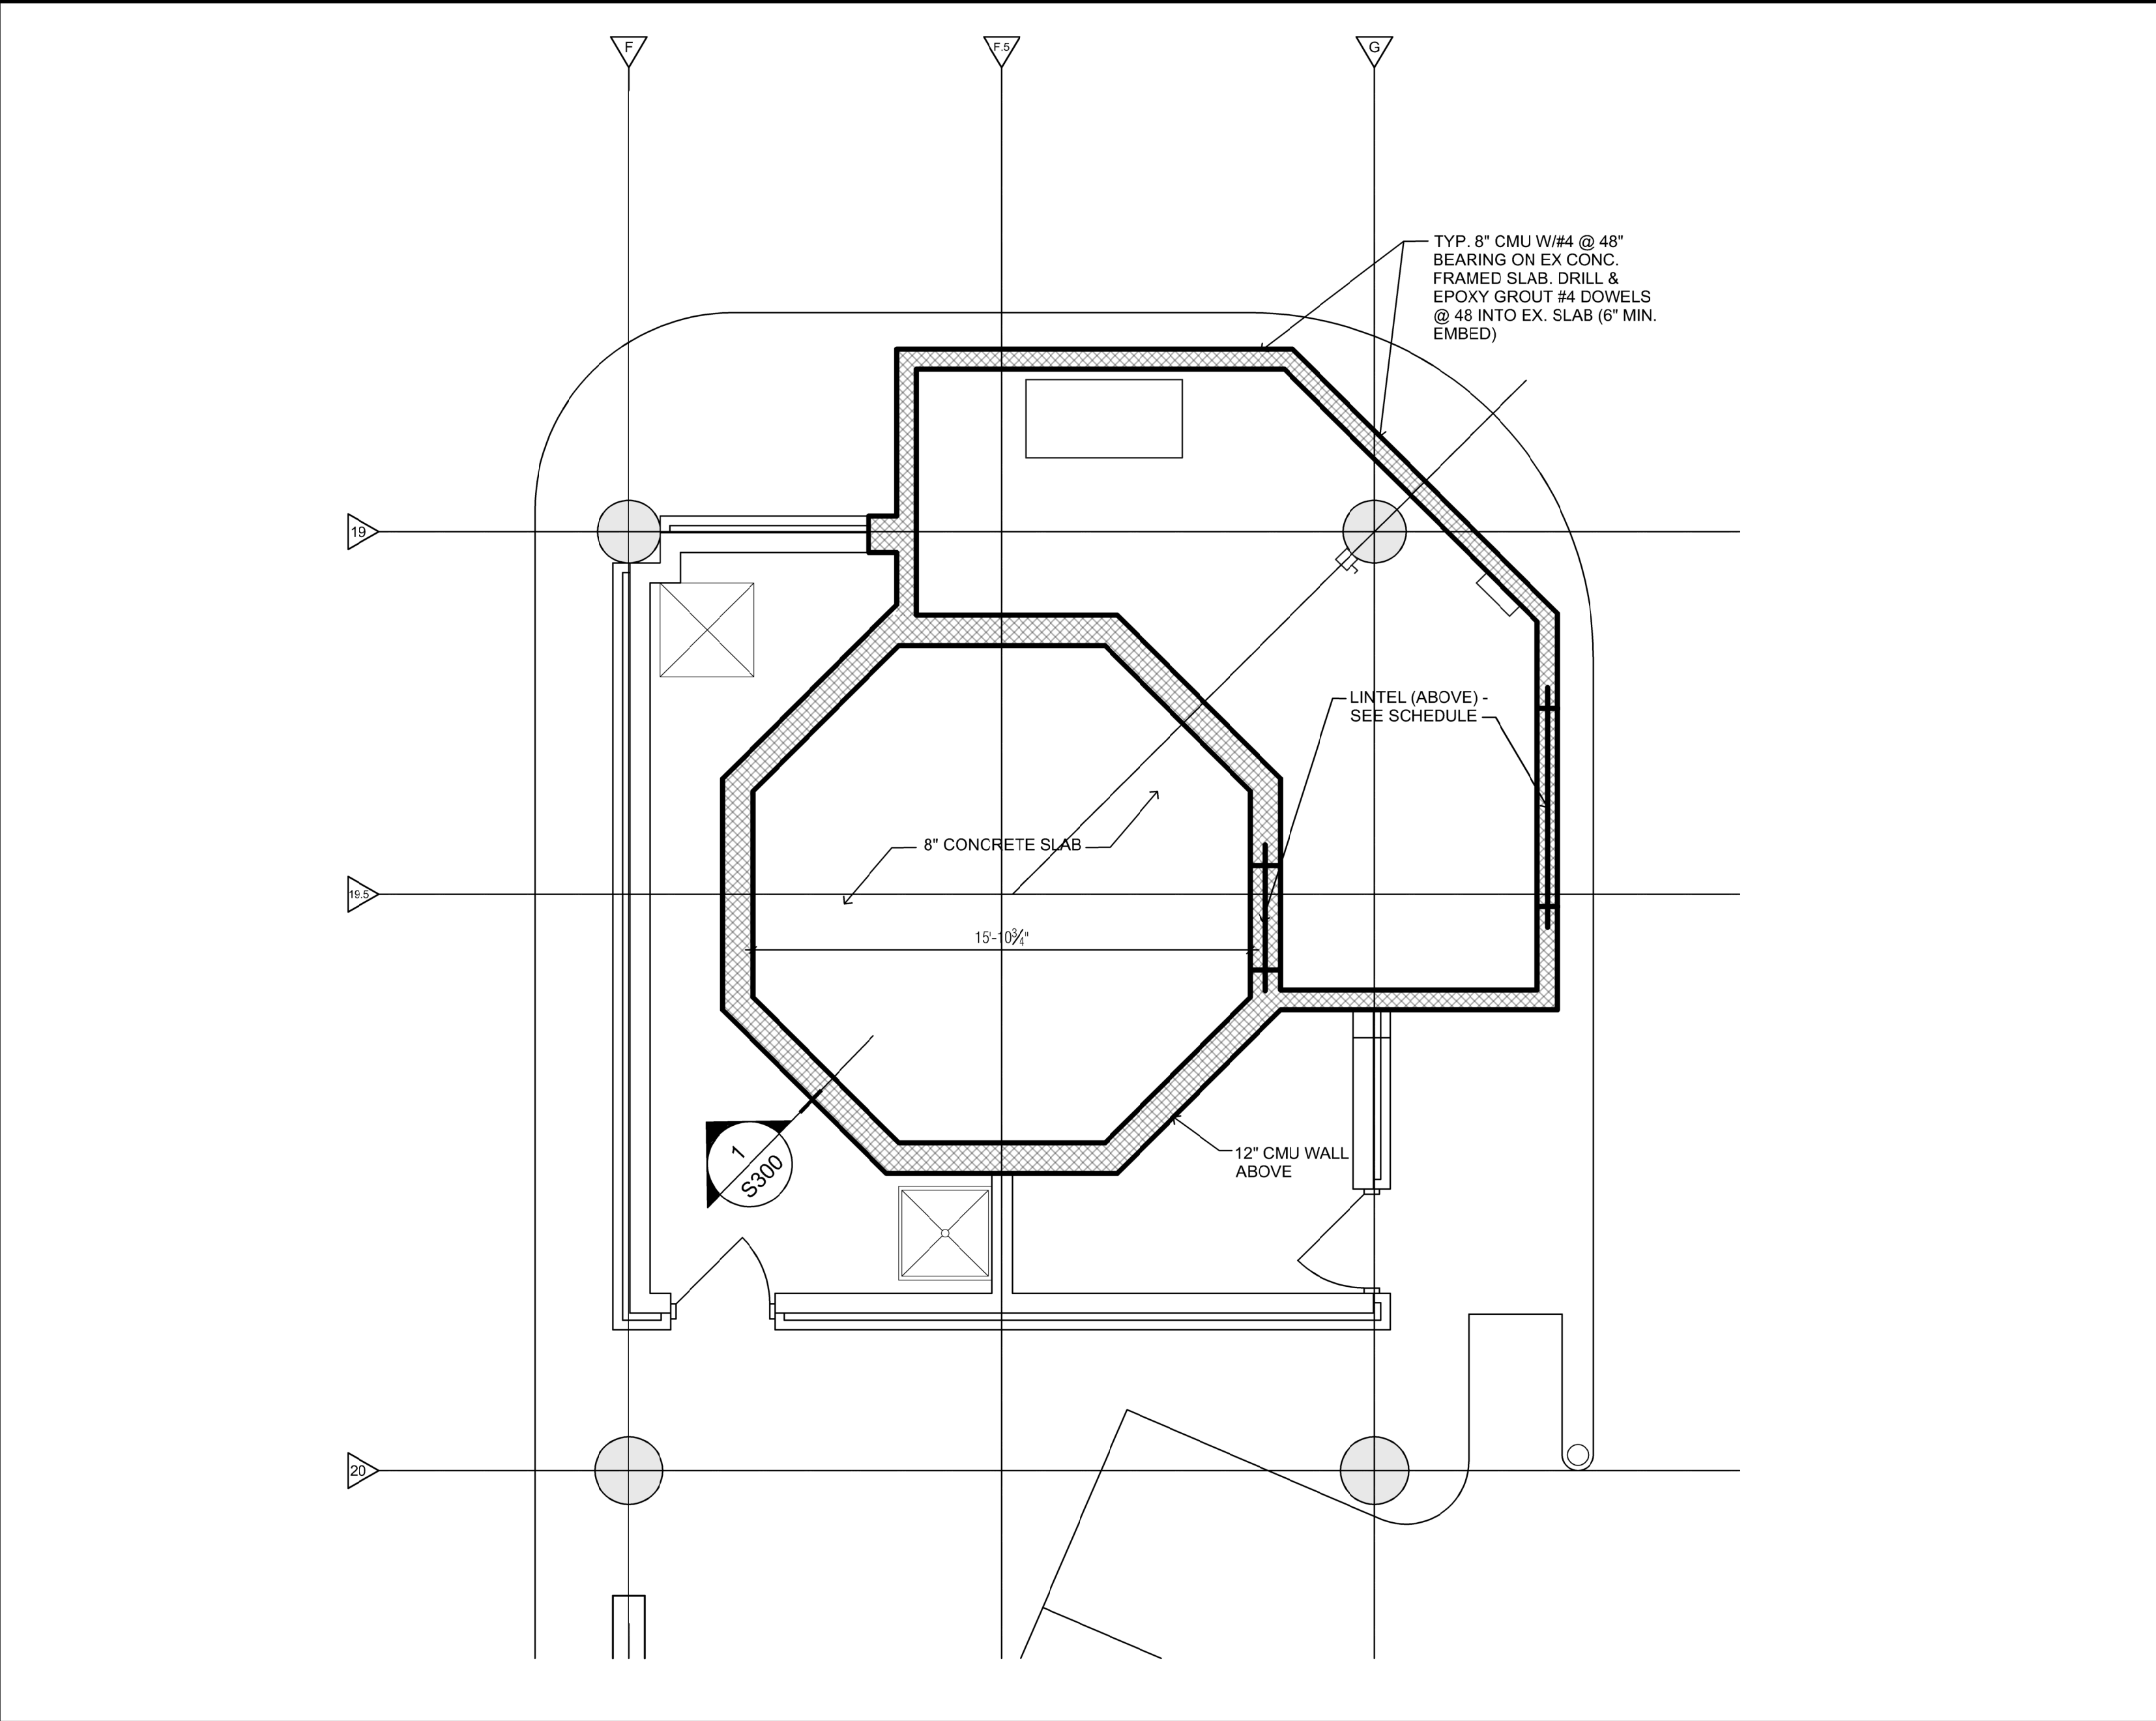

PARTIAL FRAMING PLAN ELEVATOR MACHINE ROOM (FL_EL335'-1") 02

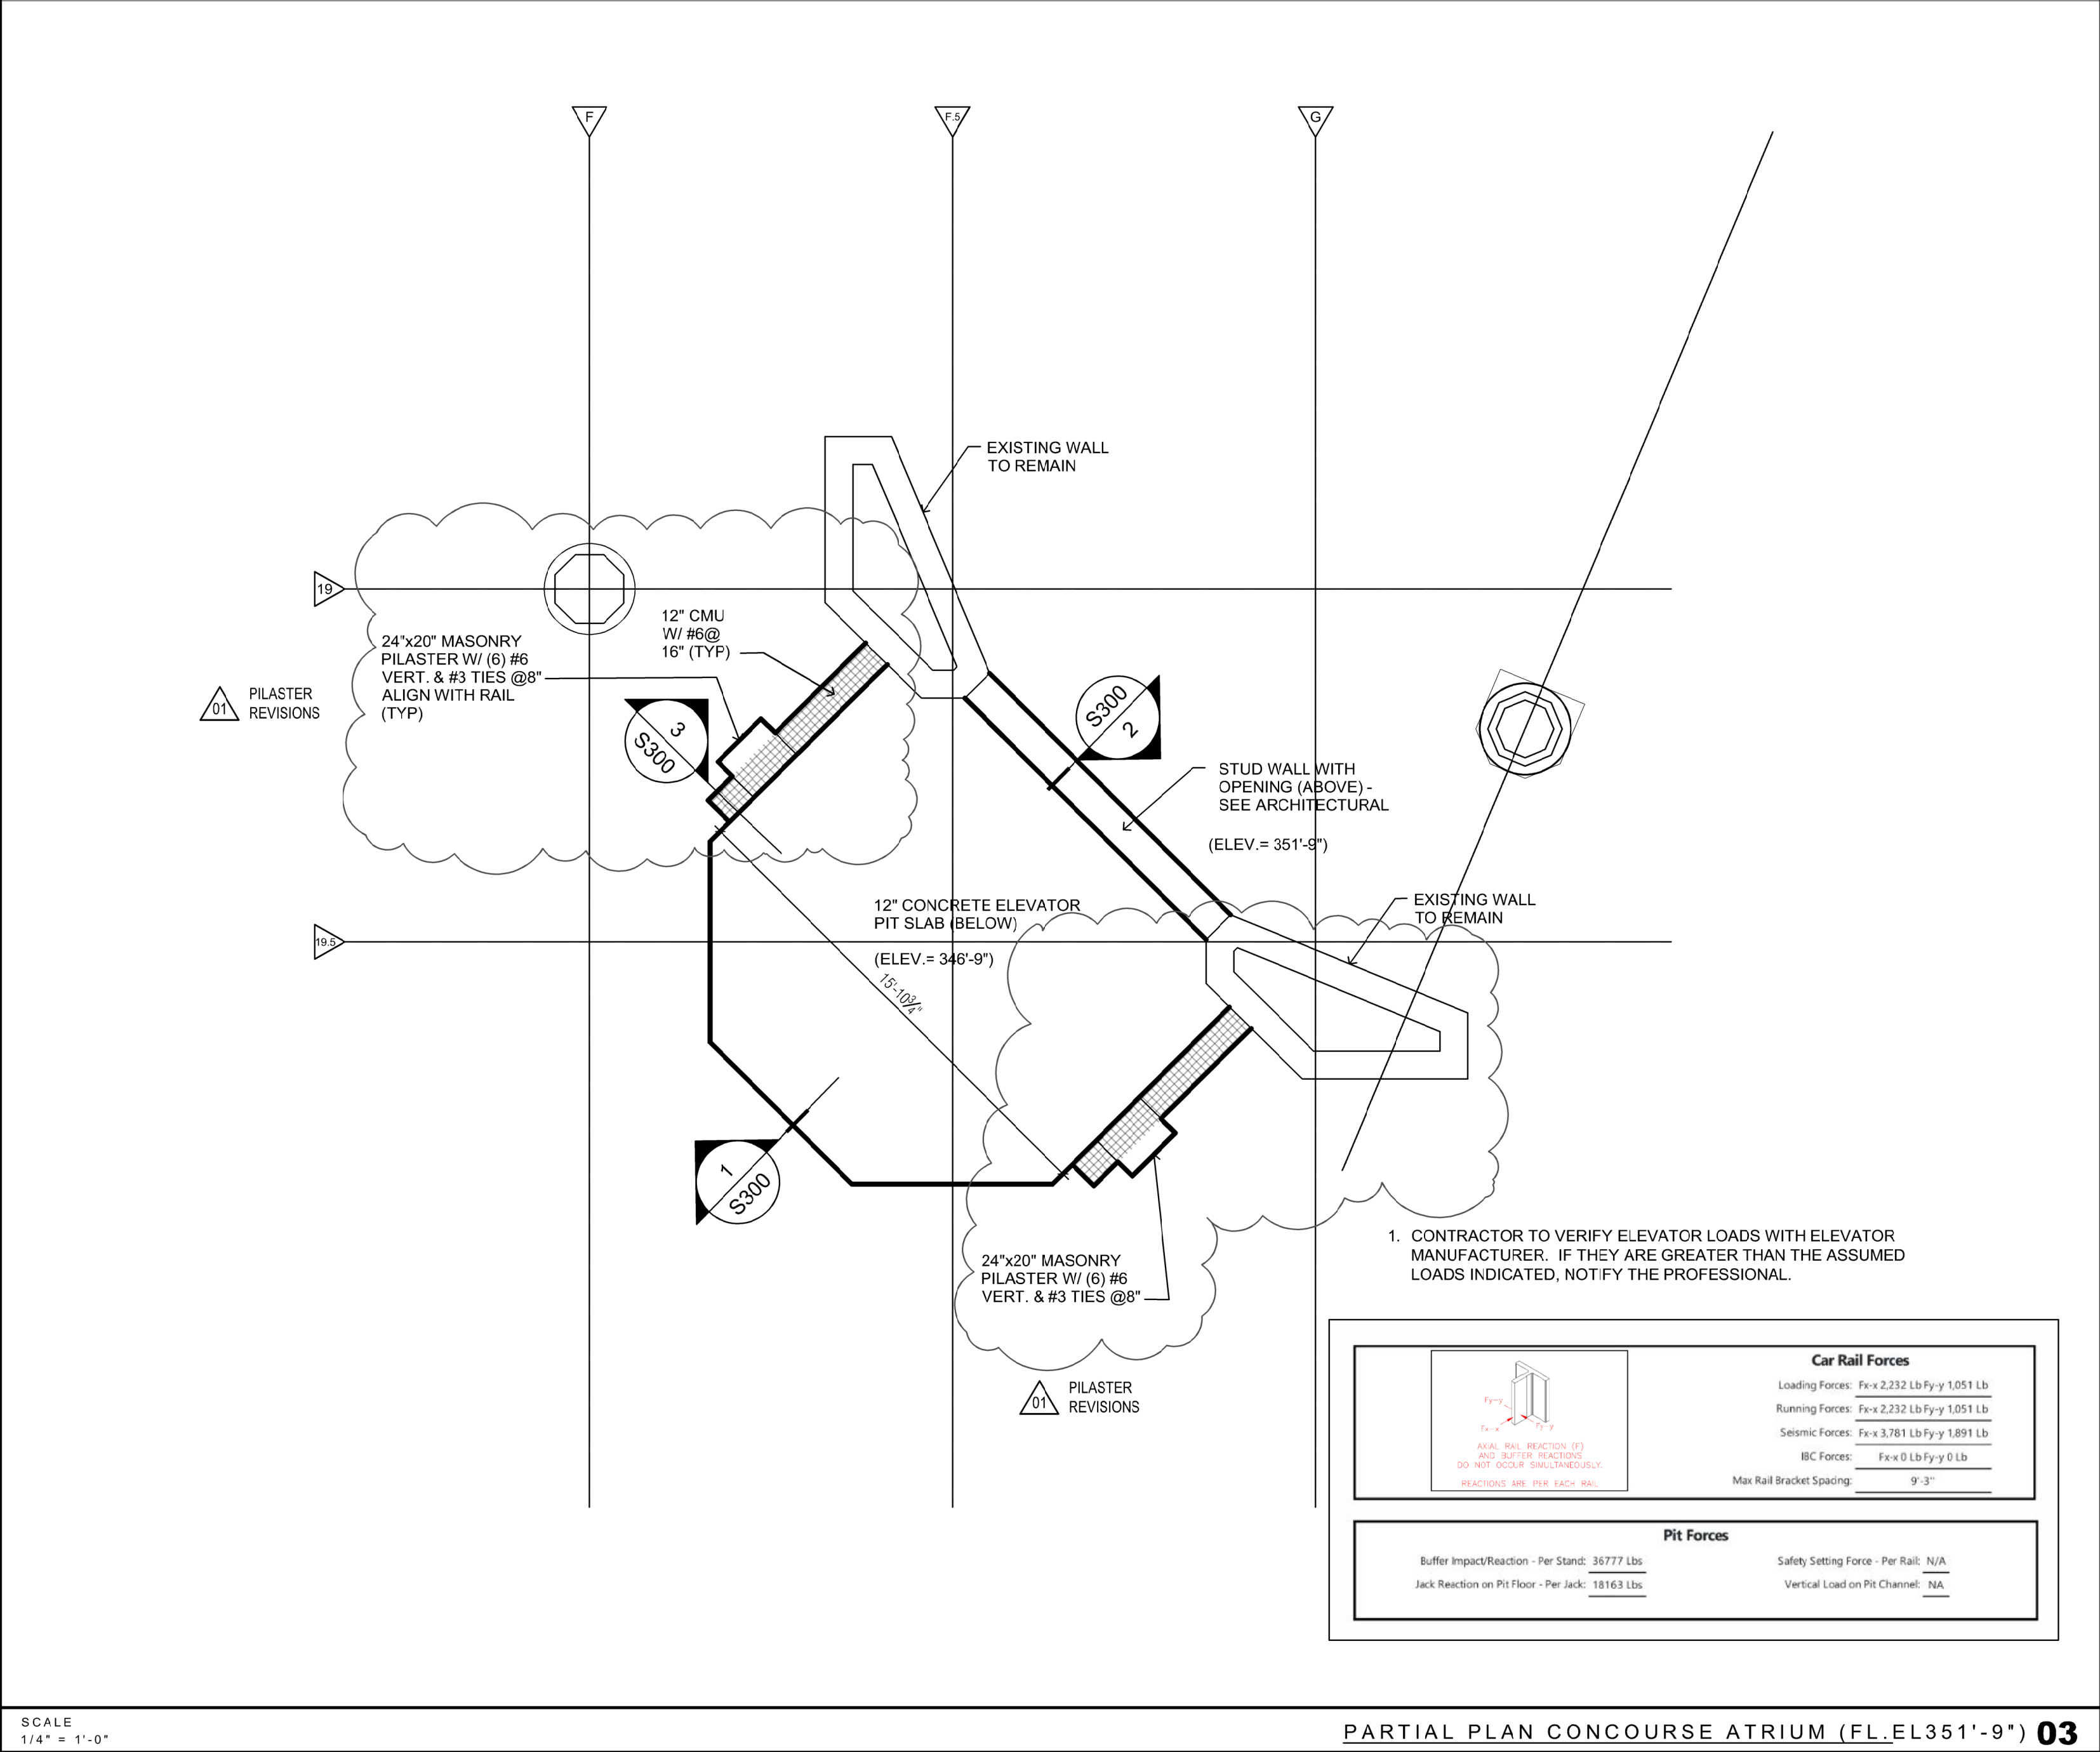

SCALE: 1/4" = 1'-0"

PARTIAL PLAN CONCOURSE ATRIUM (FL_EL351'-9") 03

SCALE & DIMENSIONS	BASE BIDS
BAR IS ONE (1) INCH LONG ON ORIGINAL DRAWING 0 1 IF BAR IS NOT ONE (1) INCH LONG, ADJUST SCALE ACCORDINGLY. CONTRACTOR SHALL FIELD VERIFY ALL DIMENSIONS. VARIANCE FROM CONTRACT NOT PERMITTED WITHOUT BUREAU OF ENGINEERING AND ARCHITECTURE APPROVAL.	ALL WORK SHOWN ON THIS DRAWING IS INCLUDED IN BASE BID 01, UNLESS NOTED OTHERWISE ON THIS DRAWING. REFER TO PROJECT MANUAL FOR FULL DESCRIPTION OF ALL BASE BIDS.

VITETTA PROJECT 4645-0000 © 2024 VITETTA
ALL DIMENSIONS MUST BE VERIFIED BY THE CONTRACTOR AND THE ARCHITECT NOTIFIED OF ANY DISCREPANCIES BEFORE PROCEEDING WITH THE CONSTRUCTION
DO NOT SCALE THIS DRAWING

19	20
17	18
15	16
13	14
11	12
09	10
07	08
05	06
03	04
01	02
No.	DESCRIPTION

AS-BUILT REVISIONS

02.12.2024
VITETTA Professional's Signature

02.12.2024
Consultant Professional's Signature Date

CONSULTANT

VITETTA **BUCHART HORN**

ARCHITECTURE | ENGINEERING | PLANNING
STRUCTURAL ENGINEER

645 NORTH 12TH STREET • SUITE 100
LEWISBURG • PENNSYLVANIA • 17043

BUCHART HORN, INC.
STRUCTURAL ENGINEER
140 EAST MARKET STREET
YORK • PENNSYLVANIA • 17401

COMMONWEALTH OF PENNSYLVANIA DEPARTMENT OF GENERAL SERVICES HARRISBURG, PENNSYLVANIA		
DGS PROJECT NUMBER C-0948-0101 PHASE 001		
CAPITOL EAST WING REPLACEMENT OF ESCALATORS WITH ELEVATOR HVAC DIFFUSERS & CAFETERIA UPGRADES HARRISBURG, DAUPHIN COUNTY, PENNSYLVANIA		
STRUCTURAL PLANS		
DRAWN BY I.J.	DATE BID SET ISSUED 07-04-2024	DRAWING NUMBER S100
CHECKED BY R.C.	SCALE AS NOTED	

DRAWING IS INTENDED FOR COLOR PRINTING

FILE PATH: \\BHS063\proj\77445-06\08-CADD\07-Structural\S-100.dwg
LAST SAVED: 24.02.12 09:22 AM
PLOTTED BY: LUOJCEVIC
PLOTTED: 24.02.11 01:26 PM