




SCALE 3" = 1'-0"
STAIR STRINGER DETAIL 05

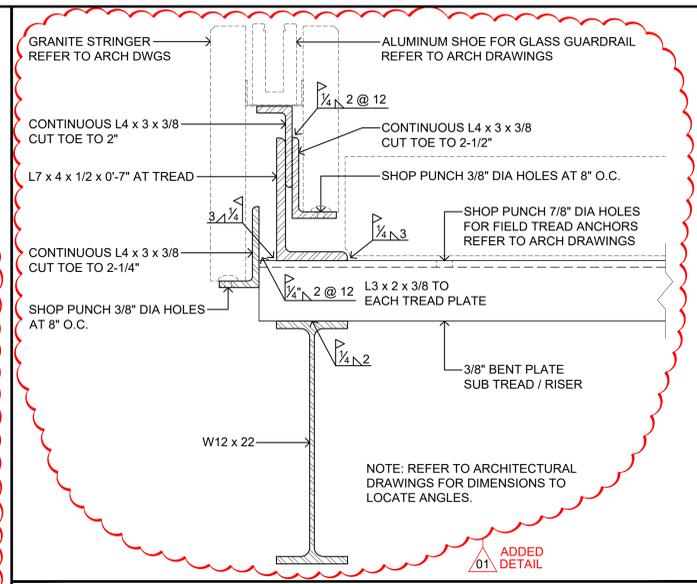


SCALE 3" = 1'-0"
STAIR STRINGER DETAIL 04

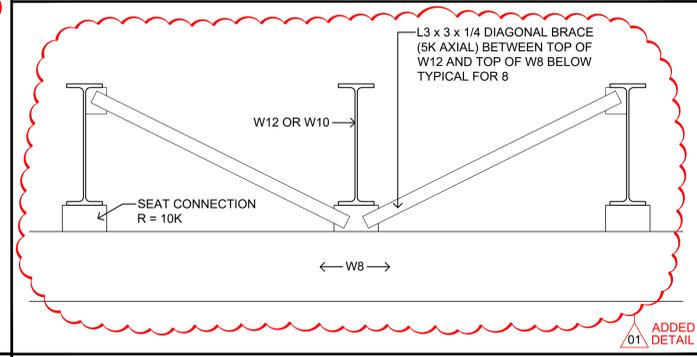

SCALE NONE
STAIR STRINGER BRACING DETAIL 03

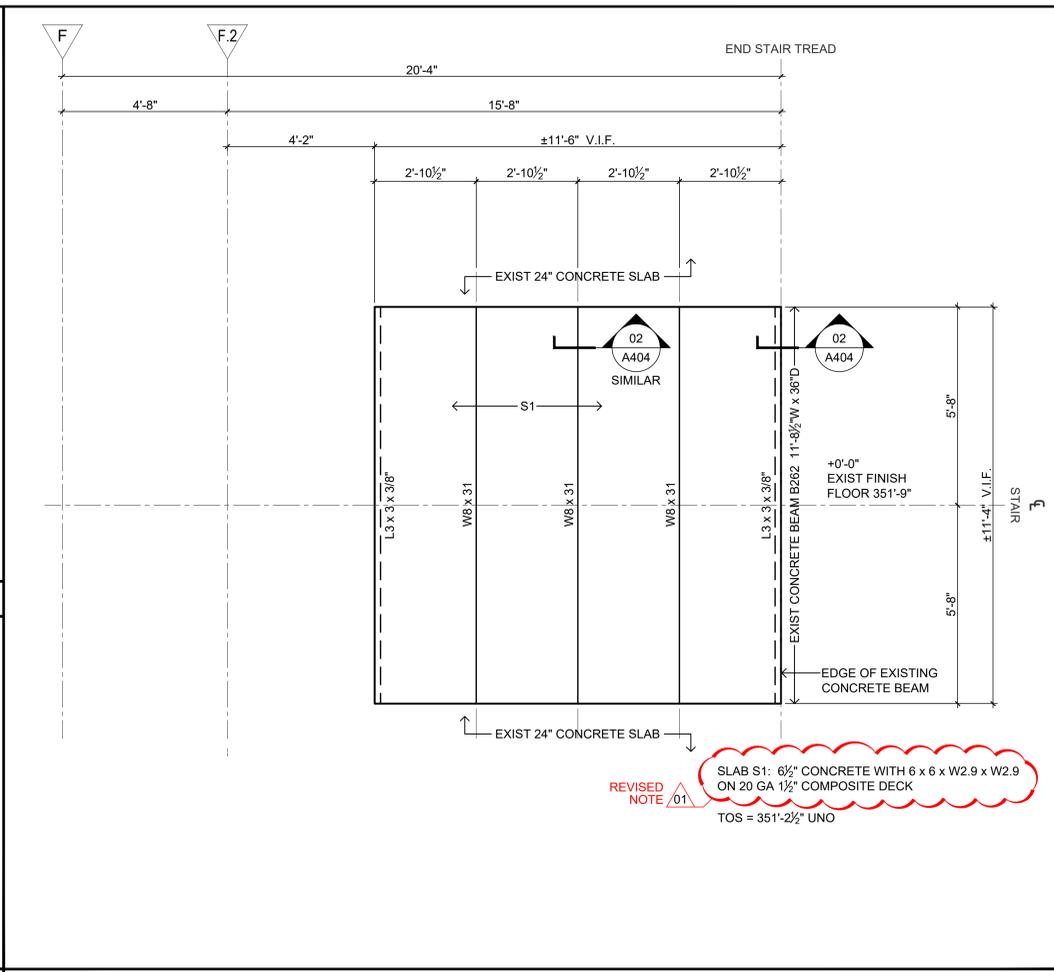

SCALE 1/2" = 1'-0"
INFILL OF EXIST ESCALATOR MACHINE PIT AT BOTTOM OF ESCALATOR/STAIR RUN 02

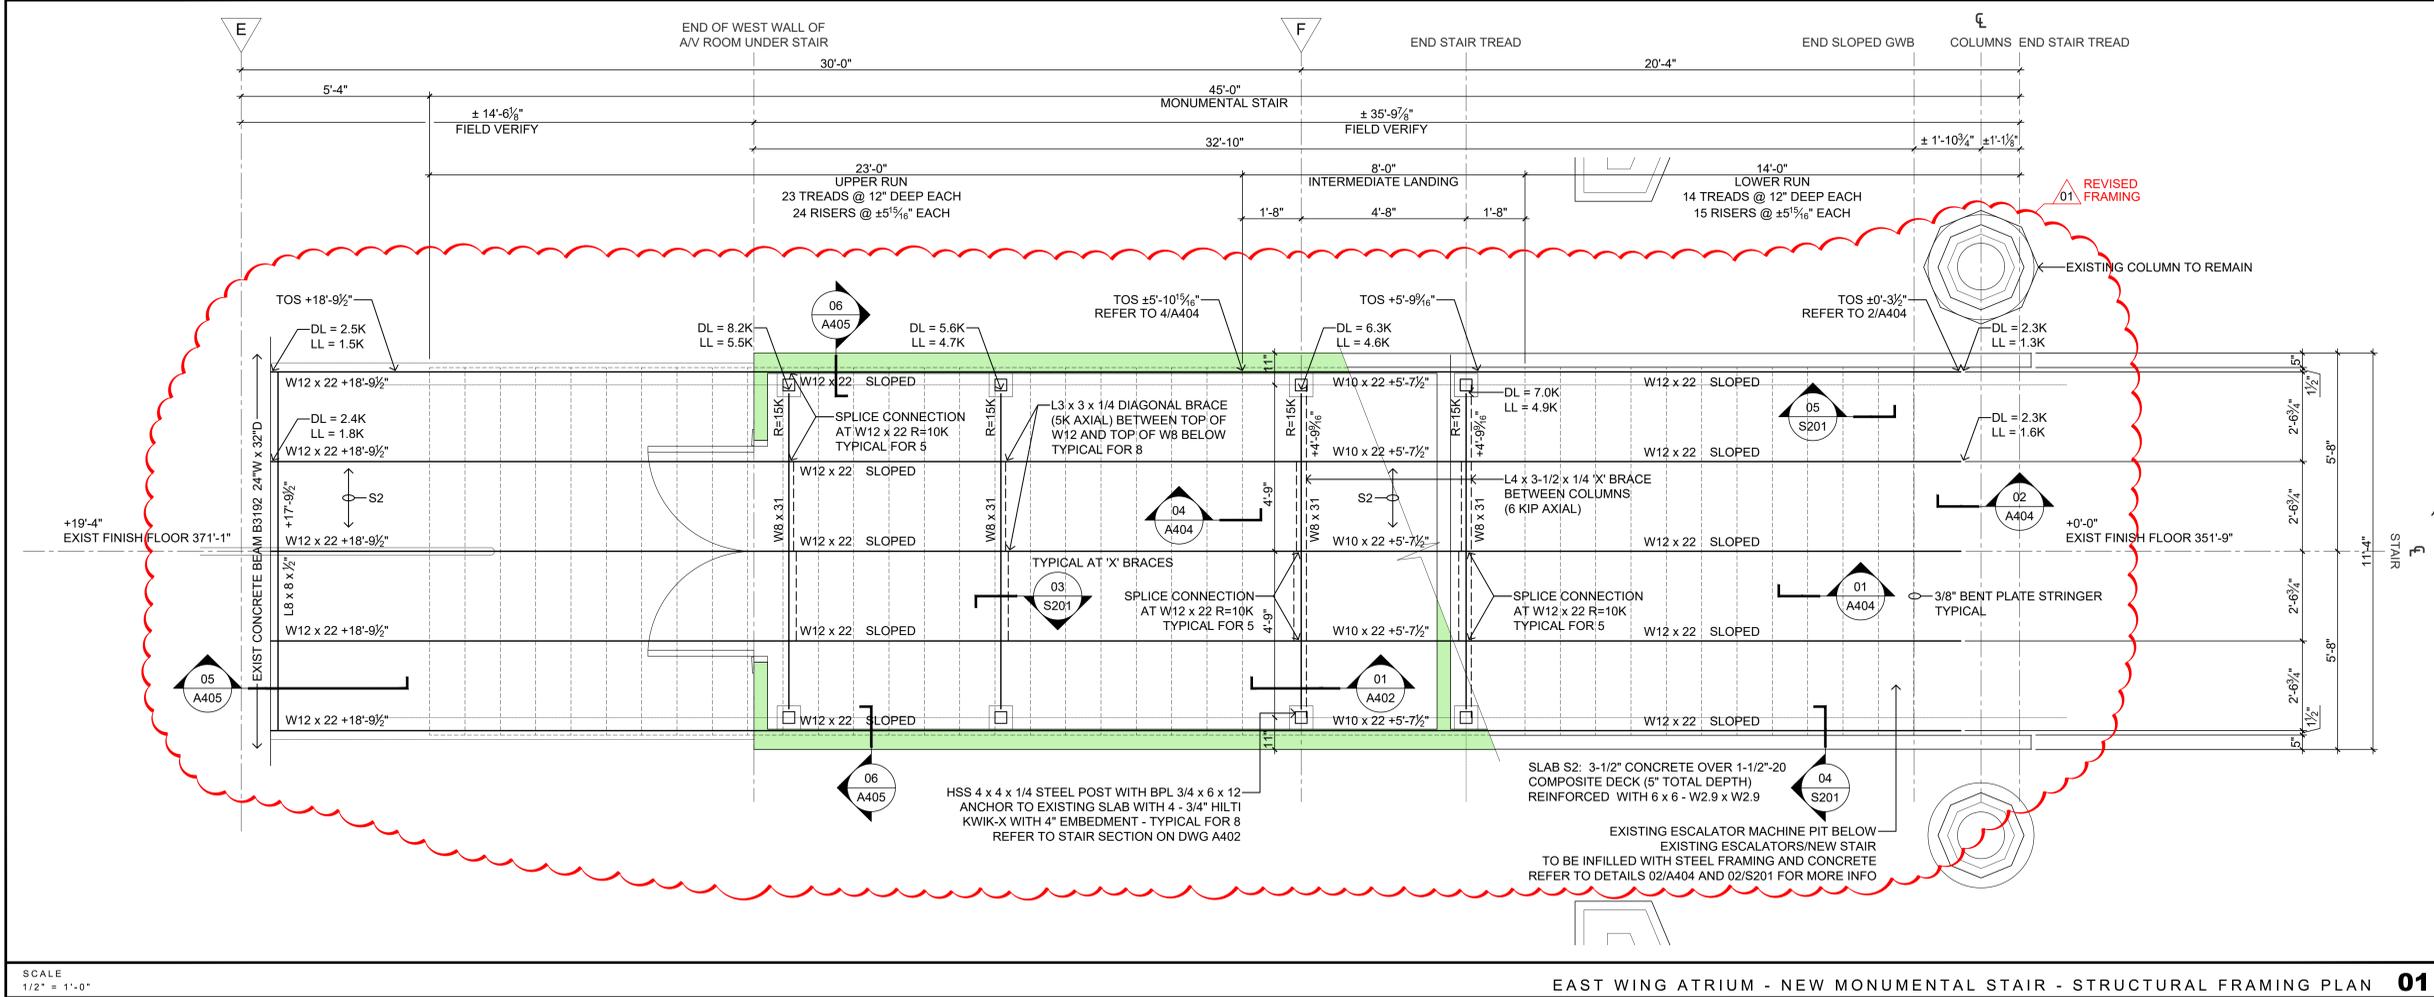

SCALE 1/2" = 1'-0"
EAST WING ATRIUM - NEW MONUMENTAL STAIR - STRUCTURAL FRAMING PLAN 01

SCALE & DIMENSIONS	BASE BIDS
<p>BAR IS ONE (1) INCH LONG ON ORIGINAL DRAWING</p> <p>IF BAR IS NOT ONE (1) INCH LONG, ADJUST SCALE ACCORDINGLY. CONTRACTOR SHALL FIELD VERIFY ALL DIMENSIONS. VARIANCE FROM CONTRACT NOT PERMITTED WITHOUT BUREAU OF ENGINEERING AND ARCHITECTURE APPROVAL.</p>	<p>ALL WORK SHOWN ON THIS DRAWING IS INCLUDED IN BASE BID 01, UNLESS NOTED OTHERWISE ON THIS DRAWING.</p> <p>REFER TO PROJECT MANUAL FOR FULL DESCRIPTION OF ALL BASE BIDS.</p>

AS-BUILT REVISIONS	
No.	DESCRIPTION
19	
17	
15	
13	
11	
09	
07	
05	
03	
01	ADDENDUM 02 02.12.2024

AS-BUILT REVISIONS	
No.	DESCRIPTION
19	
17	
15	
13	
11	
09	
07	
05	
03	
01	ADDENDUM 02 02.12.2024

VITETTA PROJECT 4645.0000 © 2024 VITETTA

ALL DIMENSIONS MUST BE VERIFIED BY THE CONTRACTOR AND THE ARCHITECT NOTIFIED OF ANY DISCREPANCIES BEFORE PROCEEDING WITH THE CONSTRUCTION. DO NOT SCALE THIS DRAWING.

02.12.2024

VITETTA Professional's Signature _____ Consultant's Signature _____ Date

CONSULTANT

VITETTA

ARCHITECTURE | ENGINEERING | PLANNING
HYDRO | PRESERVATION

645 NORTH 12TH STREET • SUITE 100
LEMOYNE • PENNSYLVANIA • 17043

COMMONWEALTH OF PENNSYLVANIA
DEPARTMENT OF GENERAL SERVICES

HARRISBURG, PENNSYLVANIA

DGS PROJECT NUMBER
C-0948-0101 PHASE 001

CAPITOL EAST WING
REPLACEMENT OF ESCALATORS WITH ELEVATOR
HVAC DIFFUSERS & CAFETERIA UPGRADES

HARRISBURG, DAUPHIN COUNTY, PENNSYLVANIA

EAST WING ATRIUM
MONUMENTAL STAIR
FRAMING PLAN & DETAILS

DRAWN BY J. JOLIN	DATE 01.04.2024	DRAWING NUMBER S201
CHECKED BY D. VOZDZAK	SCALE AS NOTED	

DRAWING IS INTENDED FOR COLOR PRINTING

FILEPATH: P:\Projects\4645_00\STRUCT\01\4645_S201_Stair-Framing-Plan_Dwg.dwg
 PLOTTED BY: CLOS
 PLOTTED: 24.02.13.10:40 AM