


REVIS
SECTION


SECTION 01

SCALE 1/2" = 1'-0"

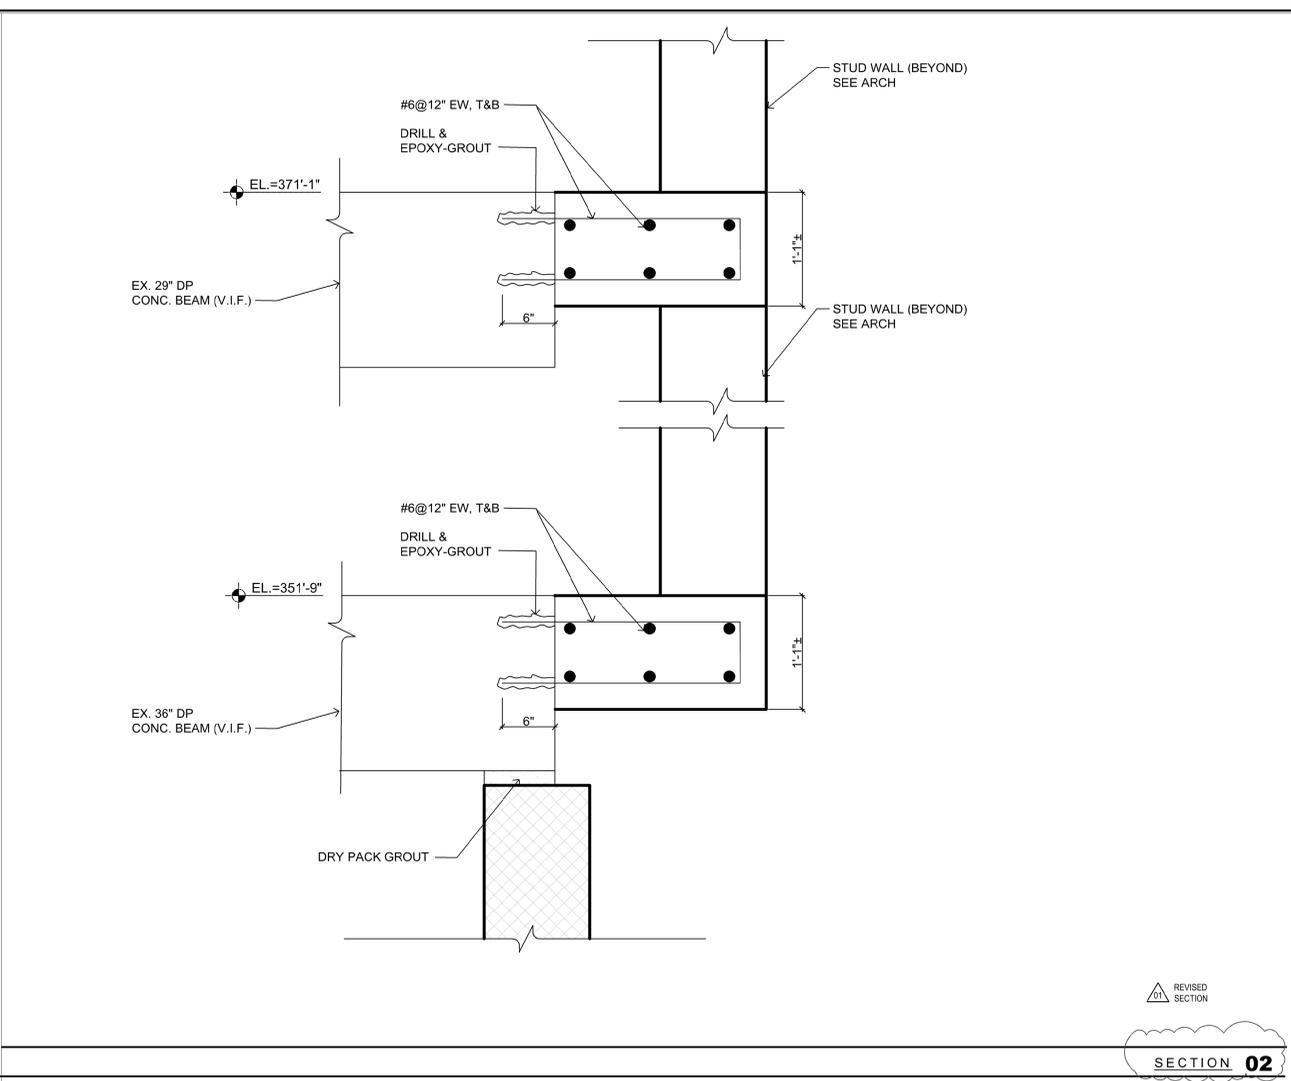

REVIS
SECTION

SECTION 02

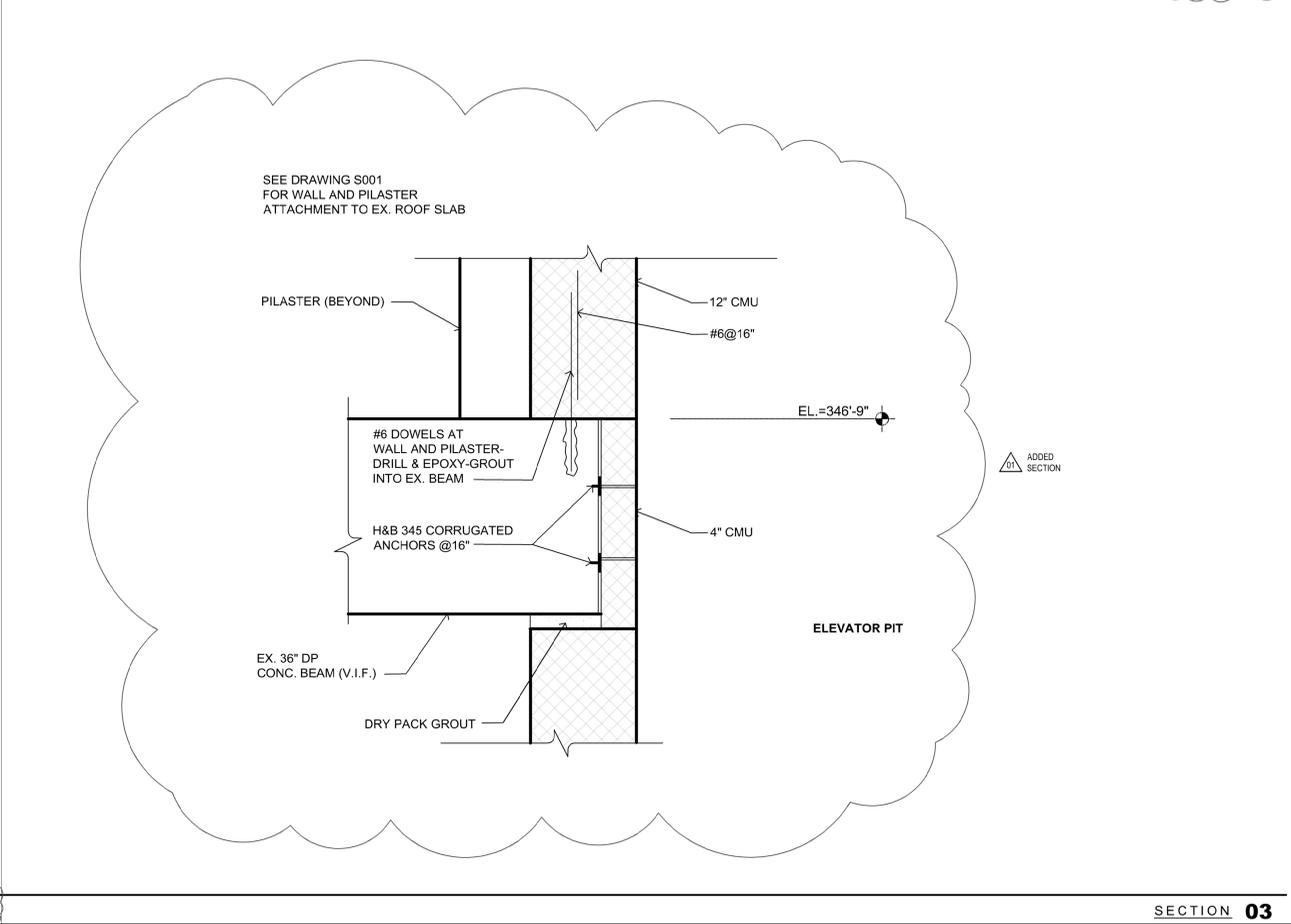

ADDED
SECTION

SECTION 03

SCALE & DIMENSIONS	BASE BIDS
<p>BAR IS ONE (1) INCH LONG ON ORIGINAL DRAWING</p> <p>IF BAR IS NOT ONE (1) INCH LONG, ADJUST SCALE ACCORDINGLY. CONTRACTOR SHALL FIELD VERIFY ALL DIMENSIONS. VARIANCE FROM CONTRACT NOT PERMITTED WITHOUT BUREAU OF ENGINEERING AND ARCHITECTURE APPROVAL.</p>	<p>ALL WORK SHOWN ON THIS DRAWING IS INCLUDED IN BASE BID 01, UNLESS NOTED OTHERWISE ON THIS DRAWING.</p> <p>REFER TO PROJECT MANUAL FOR FULL DESCRIPTION OF ALL BASE BIDS.</p>

VITETTA PROJECT 4645 0000		© 2024 VITETTA	
19	20	19	20
17	18	17	18
15	16	15	16
13	14	13	14
11	12	11	12
09	10	09	10
07	08	07	08
05	06	05	06
03	04	03	04
01	02	01	02
No.	DESCRIPTION	No.	DESCRIPTION
AS-BUILT REVISIONS			

02.12.2024

VITETTA Professional's Signature

CONSULTANT

VITETTA BUCHART HORN

ARCHITECTURE | ENGINEERING | PLANNING

645 NORTH 42ND STREET • SUITE 100
LEMOYNE • PENNSYLVANIA • 17043

BUCHART HORN, INC.
STRUCTURAL ENGINEER
140 EAST MARKET STREET
YORK • PENNSYLVANIA • 17401

02.12.2024

Consultant Professional's Signature

Date

COMMONWEALTH OF PENNSYLVANIA DEPARTMENT OF GENERAL SERVICES	
HARRISBURG, PENNSYLVANIA	
DGS PROJECT NUMBER	C-0948-0101 PHASE 001
CAPITOL EAST WING REPLACEMENT OF ESCALATORS WITH ELEVATOR HVAC DIFFUSERS & CAFETERIA UPGRADES	
HARRISBURG, DAUPHIN COUNTY, PENNSYLVANIA	
STRUCTURAL SECTIONS	
DRAWN BY I.J.	DATE 01-04-2024
CHECKED BY R.C.	SCALE AS NOTED
DRAWING NUMBER S300	

DRAWING IS INTENDED FOR COLOR PRINTING

FILE PATH: \\bhsdc63\proj\7445-06\08-CADD\07-Structural\S-300.dwg
LAST SAVED: 24.02.11 01:26 PM
PLOTTED BY: LUOJCEVIC
PLOTTED: 24.02.12 09:29 AM