


ENLARGED PLAN OF MONUMENTAL STAIR IN EAST WING ATRIUM (CONCOURSE LEVEL WITH LEVEL 1 SHOWN DASHED) **02**

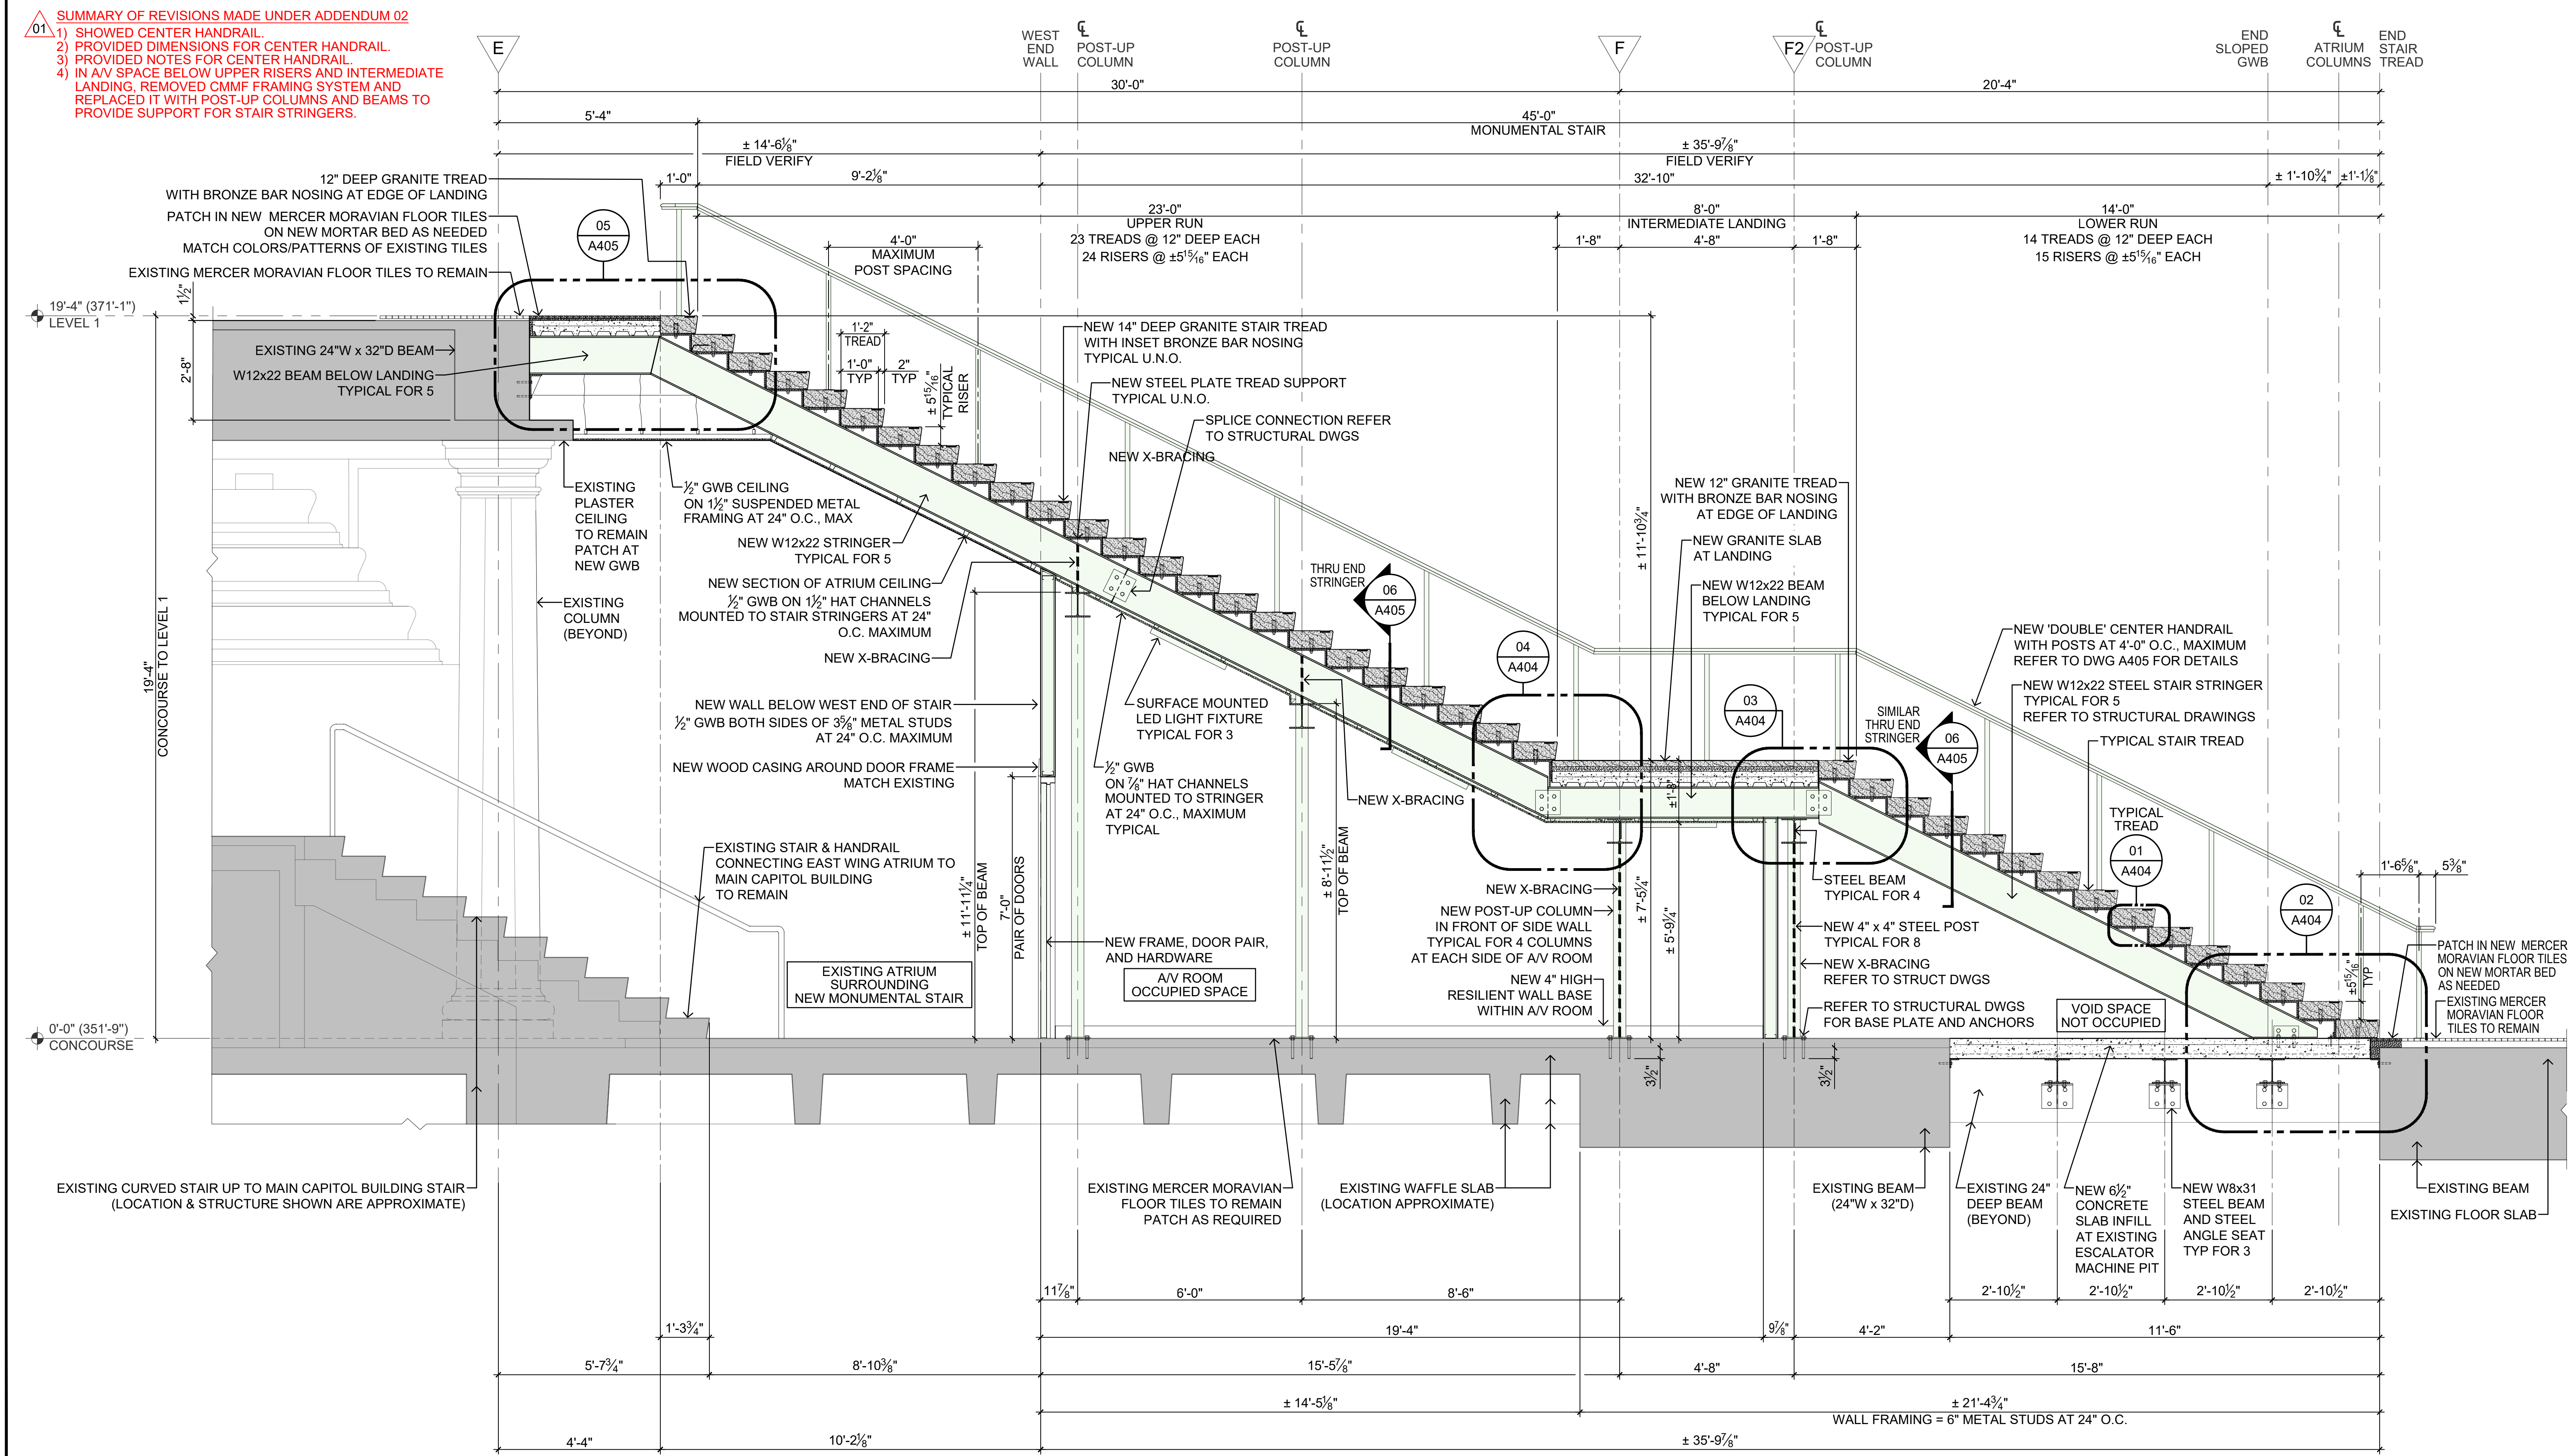

SECTION THRU NEW MONUMENTAL STAIR IN EAST WING ATRIUM SHOWING MODIFIED A/V ROOM BELOW STAIR **01**

SCALE & DIMENSIONS

BAR IS ONE (1) INCH LONG ON ORIGINAL DRAWING  
0 1  
IF BAR IS NOT ONE (1) INCH LONG, ADJUST SCALE ACCORDINGLY. CONTRACTOR SHALL FIELD VERIFY ALL DIMENSIONS. VARIANCE FROM CONTRACT NOT PERMITTED WITHOUT BUREAU OF ENGINEERING AND ARCHITECTURE APPROVAL.

BASE BIDS

ALL WORK SHOWN ON THIS DRAWING IS INCLUDED IN BASE BID 01, UNLESS NOTED OTHERWISE ON THIS DRAWING.  
REFER TO PROJECT MANUAL FOR FULL DESCRIPTION OF ALL BASE BIDS.

GENERAL NOTES FOR NEW STAIR

- DO NOT SCALE DRAWING A401 DIAGRAM OF ESCALATOR & STAIR IN EACH WING ATRIUM (LOOKING NORTH). REFER TO THE OTHER DRAWINGS THE IN A400 SERIES FOR DIMENSIONS.
- REFER TO DETAIL 01/A402 FOR LONGITUDINAL SECTION THROUGH NEW MONUMENTAL STAIR.
- REFER TO DETAIL 01/A403 FOR ELEVATION OF SOUTH SIDE OF NEW MONUMENTAL STAIR.
- REFER TO DETAIL 02/A403 FOR ELEVATION OF NORTH SIDE OF NEW MONUMENTAL STAIR.
- REFER TO DRAWINGS A404 & A405 FOR LARGE SCALE DETAILS RELATED TO MONUMENTAL STAIR

VITETTA PROJECT 4645.0000

© 2024 VITETTA

ALL DIMENSIONS MUST BE VERIFIED BY THE CONTRACTOR AND THE ARCHITECT NOTIFIED OF ANY DISCREPANCIES BEFORE PROCEEDING WITH THE CONSTRUCTION. DO NOT SCALE THIS DRAWING.

19	20
17	18
15	16
13	14
11	12
09	10
07	08
05	06
03	04
01	02

No.

DESCRIPTION

No.

DESCRIPTION

AS-BUILT REVISIONS

02.12.2024

VITETTA Professional's Signature

Consultant Professional's Signature

Date

CONSULTANT

VITETTA

ARCHITECTURE | ENGINEERING | PLANNING

NOTHING PRESERVATION

645 NORTH 12TH STREET • SUITE 100

LEMOYNE • PENNSYLVANIA • 17043

COMMONWEALTH OF PENNSYLVANIA

DEPARTMENT OF GENERAL SERVICES

HARRISBURG, PENNSYLVANIA

DGS PROJECT NUMBER

C-0948-0101 PHASE 001

CAPITOL EAST WING

REPLACEMENT OF ESCALATORS WITH ELEVATOR

HVAC DIFFUSERS & CAFETERIA UPGRADES

HARRISBURG, DAUPHIN COUNTY, PENNSYLVANIA

NEW MONUMENTAL STAIR

LONGITUDINAL SECTION

DRAWN BY

R. CLOSE / J. JOLIN

DATE

BID SET ISSUED

01.04.2024

DRAWING NUMBER

A402

CHECKED BY

D. VOZDZAK

SCALE

1/2" = 1'-0", U.N.O.

FILE PATH:

P:\Projects\4645\_00\ARCH\4645\_19\_A402\_Stair\_Section.dwg

PLOTTED BY:

JOLIN

LAST SAVED:

24.02.19 12:19 PM

PLOTTED:

24.02.19 12:19 PM

DRAWING IS INTENDED FOR COLOR PRINTING