

GENERAL NOTES

- FOR THE DURATION OF CONSTRUCTION ACTIVITIES, THE 1 GENERAL CONTRACTOR SHALL PRESERVE & PROTECT EXISTING CONDITIONS TO REMAIN AND ENSURE THE BUILDING'S OCCUPANTS MAY SAFELY USE SPACES IN THE AREAS OF THE BUILDING NOT BEING RENOVATED.
- REFER TO 'A400' SERIES DRAWINGS FOR ADDITIONAL INFORMATION REGARDING THE NEW MONUMENTAL STAIR.

ADDED SIGN & NOTE
SIGN TYPE 'S2' - MOUNT TO WALL
COORDINATE LOCATION IN FIELD
REFER TO TECH SPECS FOR MORE INFO

MODIFIED HANDRAILS

ADDED SIGN & NOTE
PROVIDE SIGN TYPE 'S3'
MOUNT TO WALL
COORDINATE LOCATION IN FIELD
REFER TO TECH SPECS FOR MORE INFO

INCREASED INNER CMU FROM 8" TO 12" 01


DEMARCATON BETWEEN MORAVIAN TILE IN ATRIUM AND GRANITE PAVERS IN SPIRAL STAIR
REPLACE PAVERS WITH NEW MORAVIAN TILE

INCREASED INNER CMU FROM 8" TO 12" 01

SCALE
3/8" = 1'-0"

CONCOURSE LEVEL FLOOR PLAN - ATRIUM - NEW STAIR AND ELEVATOR 01

SCALE & DIMENSIONS	BASE BIDS
<p>BAR IS ONE (1) INCH LONG ON ORIGINAL DRAWING</p> <p>IF BAR IS NOT ONE (1) INCH LONG, ADJUST SCALE ACCORDINGLY. CONTRACTOR SHALL FIELD VERIFY ALL DIMENSIONS. VARIANCE FROM CONTRACT NOT PERMITTED WITHOUT BUREAU OF ENGINEERING AND ARCHITECTURE APPROVAL.</p>	<p>ALL WORK SHOWN ON THIS DRAWING IS INCLUDED IN BASE BID 01, UNLESS NOTED OTHERWISE ON THIS DRAWING.</p> <p>REFER TO PROJECT MANUAL FOR FULL DESCRIPTION OF ALL BASE BIDS.</p>

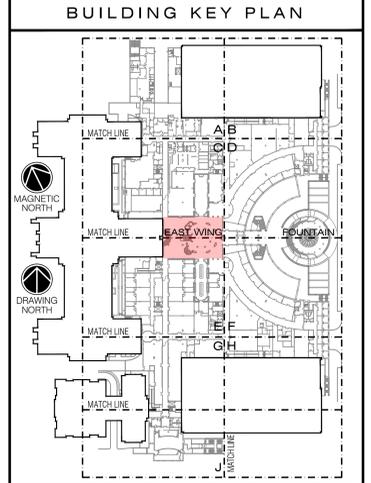

VITETTA PROJECT 4645.0000 © 2024 VITETTA

ALL DIMENSIONS MUST BE VERIFIED BY THE CONTRACTOR(S) AND THE ARCHITECT NOTIFIED OF ANY DISCREPANCIES BEFORE PROCEEDING WITH THE CONSTRUCTION. DO NOT SCALE THIS DRAWING.

19	20
17	18
15	16
13	14
11	12
09	10
07	08
05	06
03	04
01	02

No.	DESCRIPTION	No.	DESCRIPTION
01	ADDENDUM 02 02.12.2024	02	

AS-BUILT REVISIONS

02.12.2024

VITETTA Professional's Signature _____ Consultant Professional's Signature _____ Date _____

VITETTA
ARCHITECTURE | ENGINEERING | PLANNING
HISTORIC PRESERVATION
645 NORTH 12TH STREET • SUITE 100
LEMOYNE • PENNSYLVANIA • 17043

COMMONWEALTH OF PENNSYLVANIA
DEPARTMENT OF GENERAL SERVICES
HARRISBURG, PENNSYLVANIA

DGS PROJECT NUMBER
C-0948-0101 PHASE 001

CAPITOL EAST WING
REPLACEMENT OF ESCALATORS WITH ELEVATOR
HVAC DIFFUSERS & CAFETERIA UPGRADES
HARRISBURG, DAUPHIN COUNTY, PENNSYLVANIA

CONCOURSE
ATRIUM
ARCHITECTURAL RENOVATION PLAN

DRAWN BY J. JOLIN	DATE 01.04.2024	DRAWING NUMBER A213Ar
CHECKED BY D. VOZDZAK	SCALE 3/8" = 1'-0"	

DRAWING IS INTENDED FOR COLOR PRINTING

FILEPATH: P:\Projects\4645_00\ARCH\4645_12_A213Ar_Concourse-Atrium_Enlarged_RENO.dwg
 PLOTTED BY: JOLIN
 LAST SAVED: 24.02.19 11:51 AM
 PLOTTED: 24.02.19 12:22 PM