




SCALE NONE
NOT USED **08**

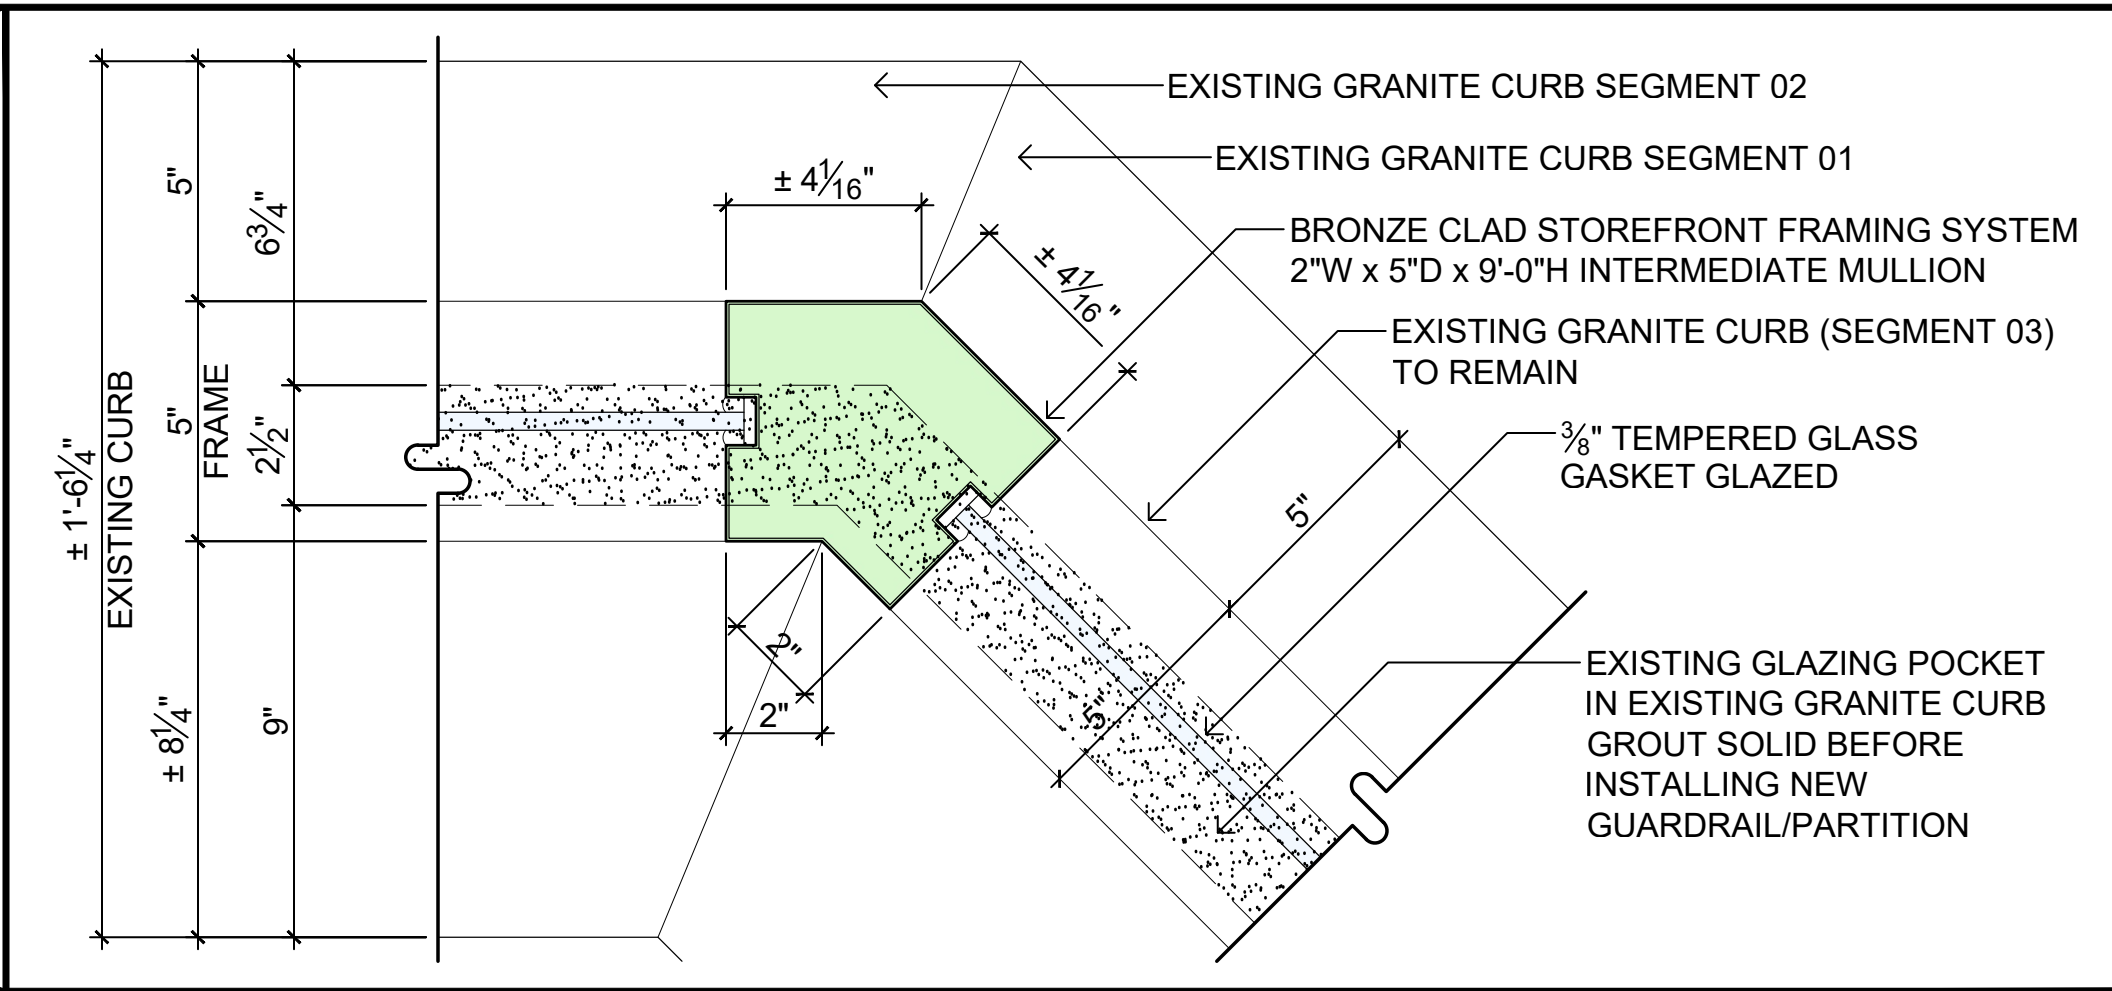


SCALE NONE
ENLARGED PLAN OF GUARDRAIL/PARTITION CORNER/VERTICAL MULLION **07**

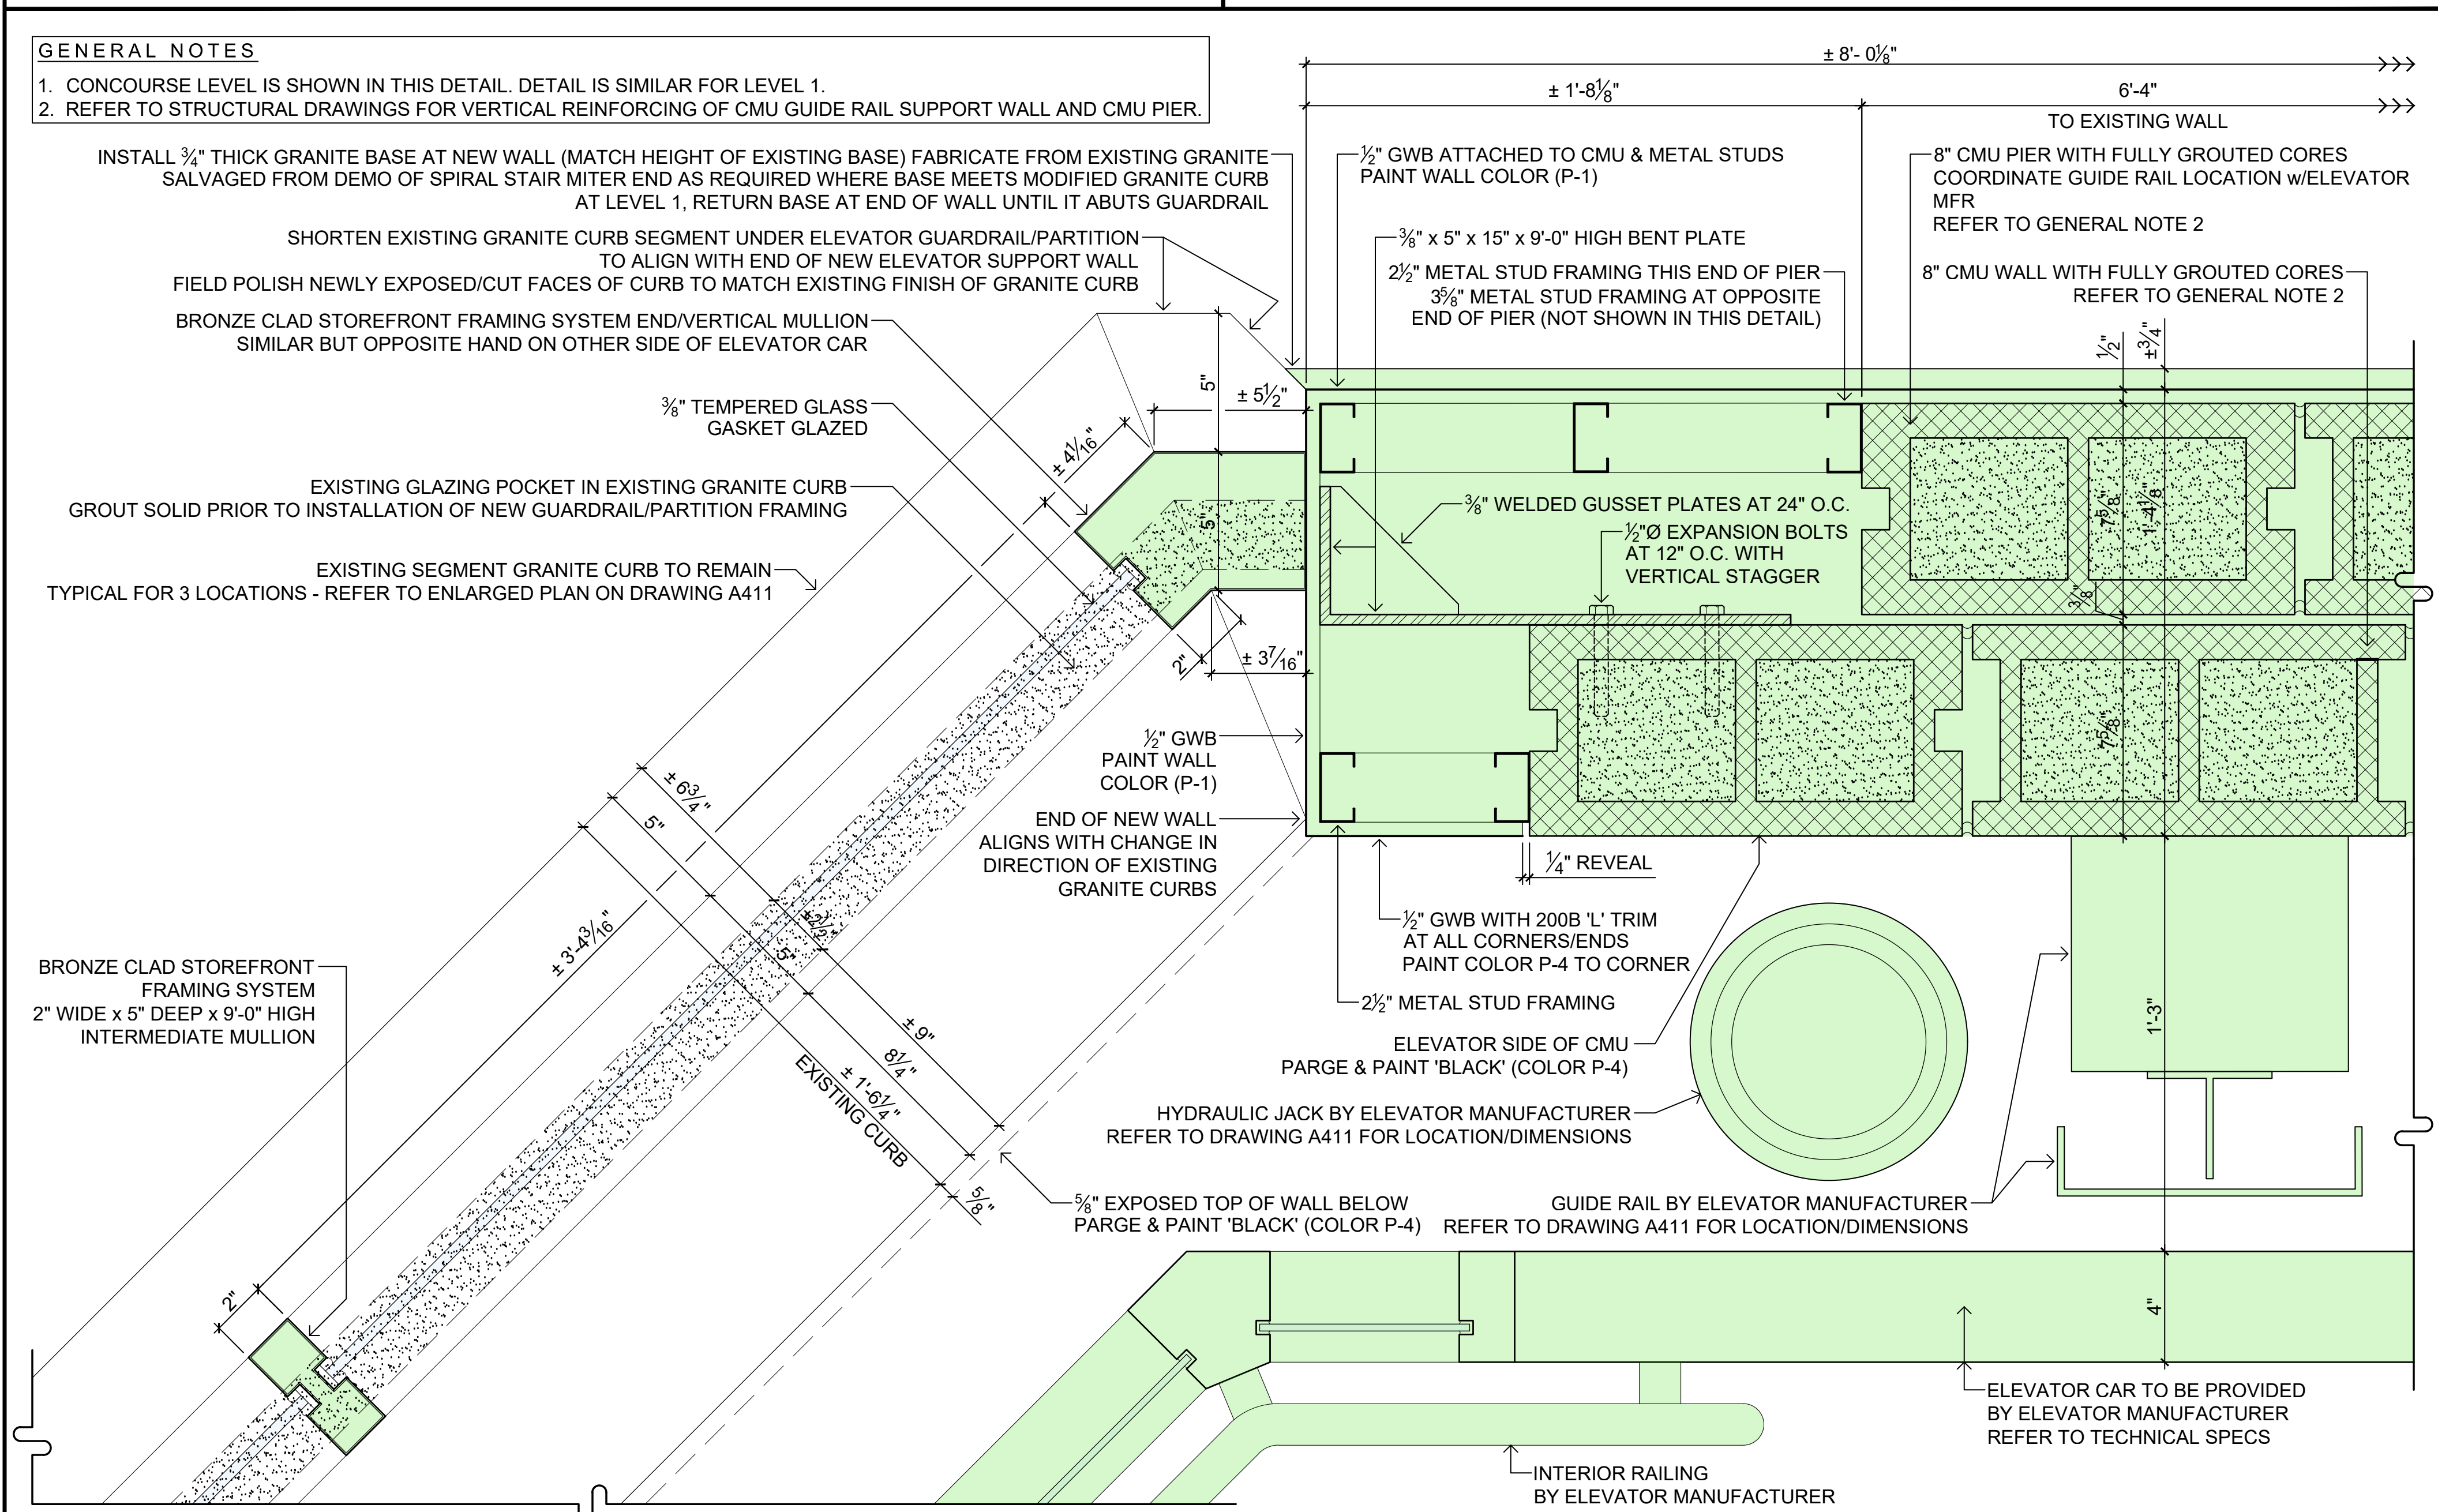


SCALE 3" = 1'-0"
ENLARGED PLAN OF ELEVATOR GUARDRAIL/PARTITION AND ELEVATOR GUIDE RAIL SUPPORT WALL **06**

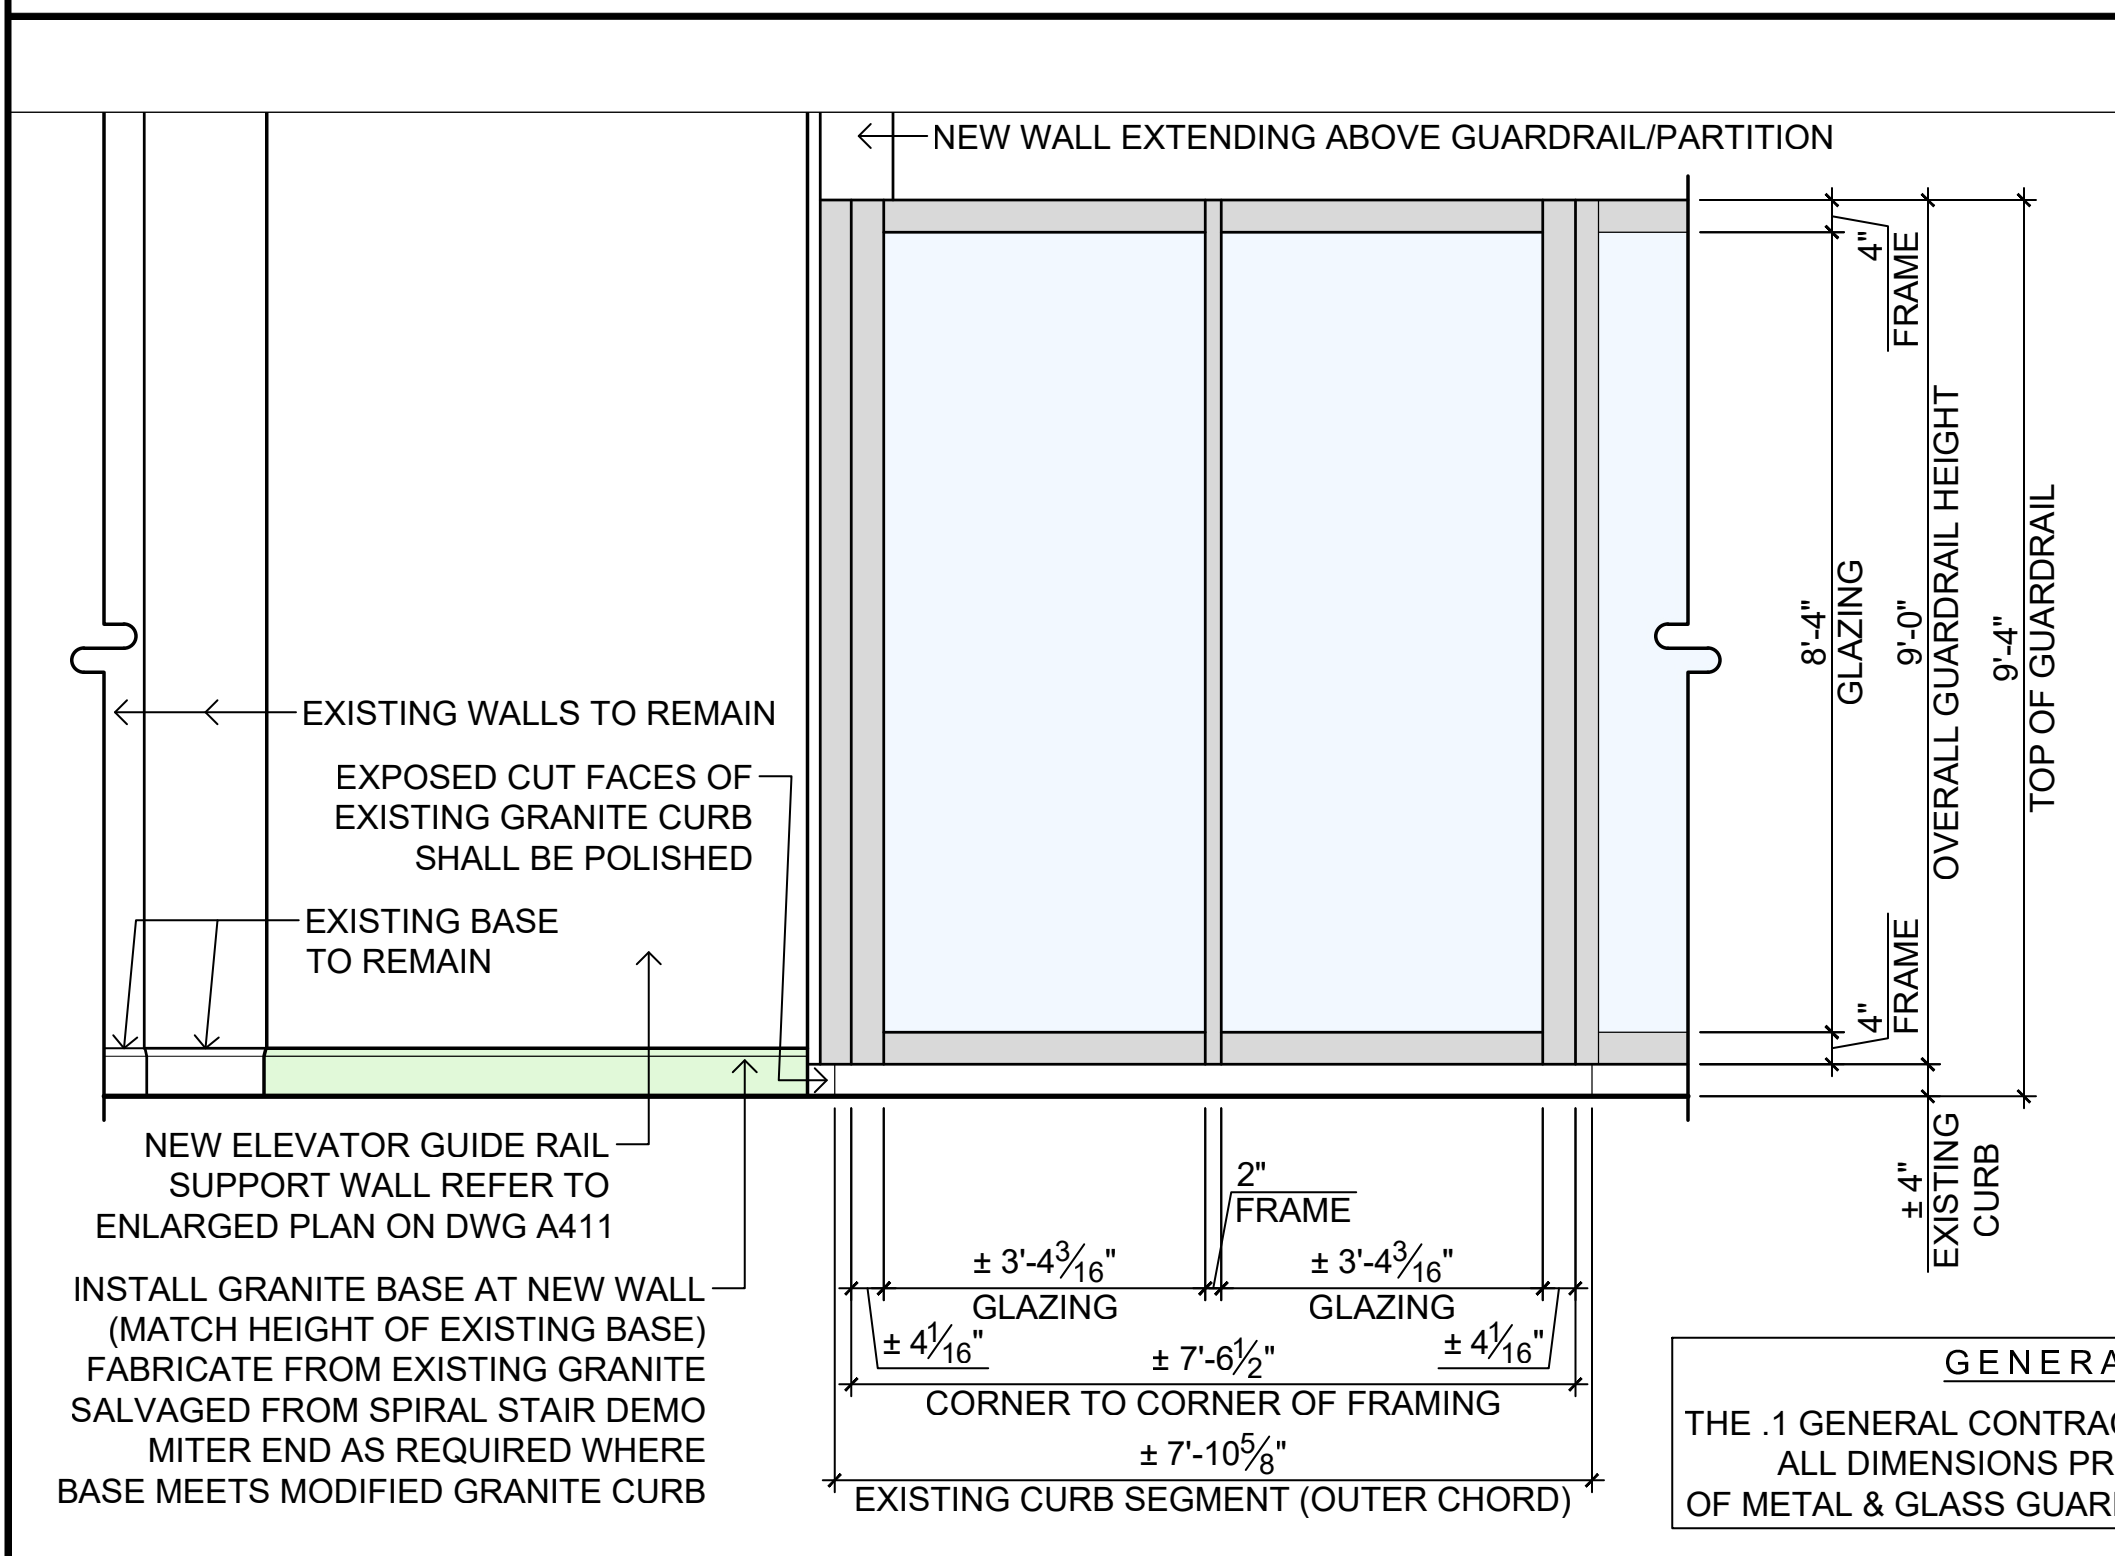


SCALE 1/2" = 1'-0"
ELEVATION OF ELEVATOR GUARDRAIL SEGMENT 01 (END) **05**

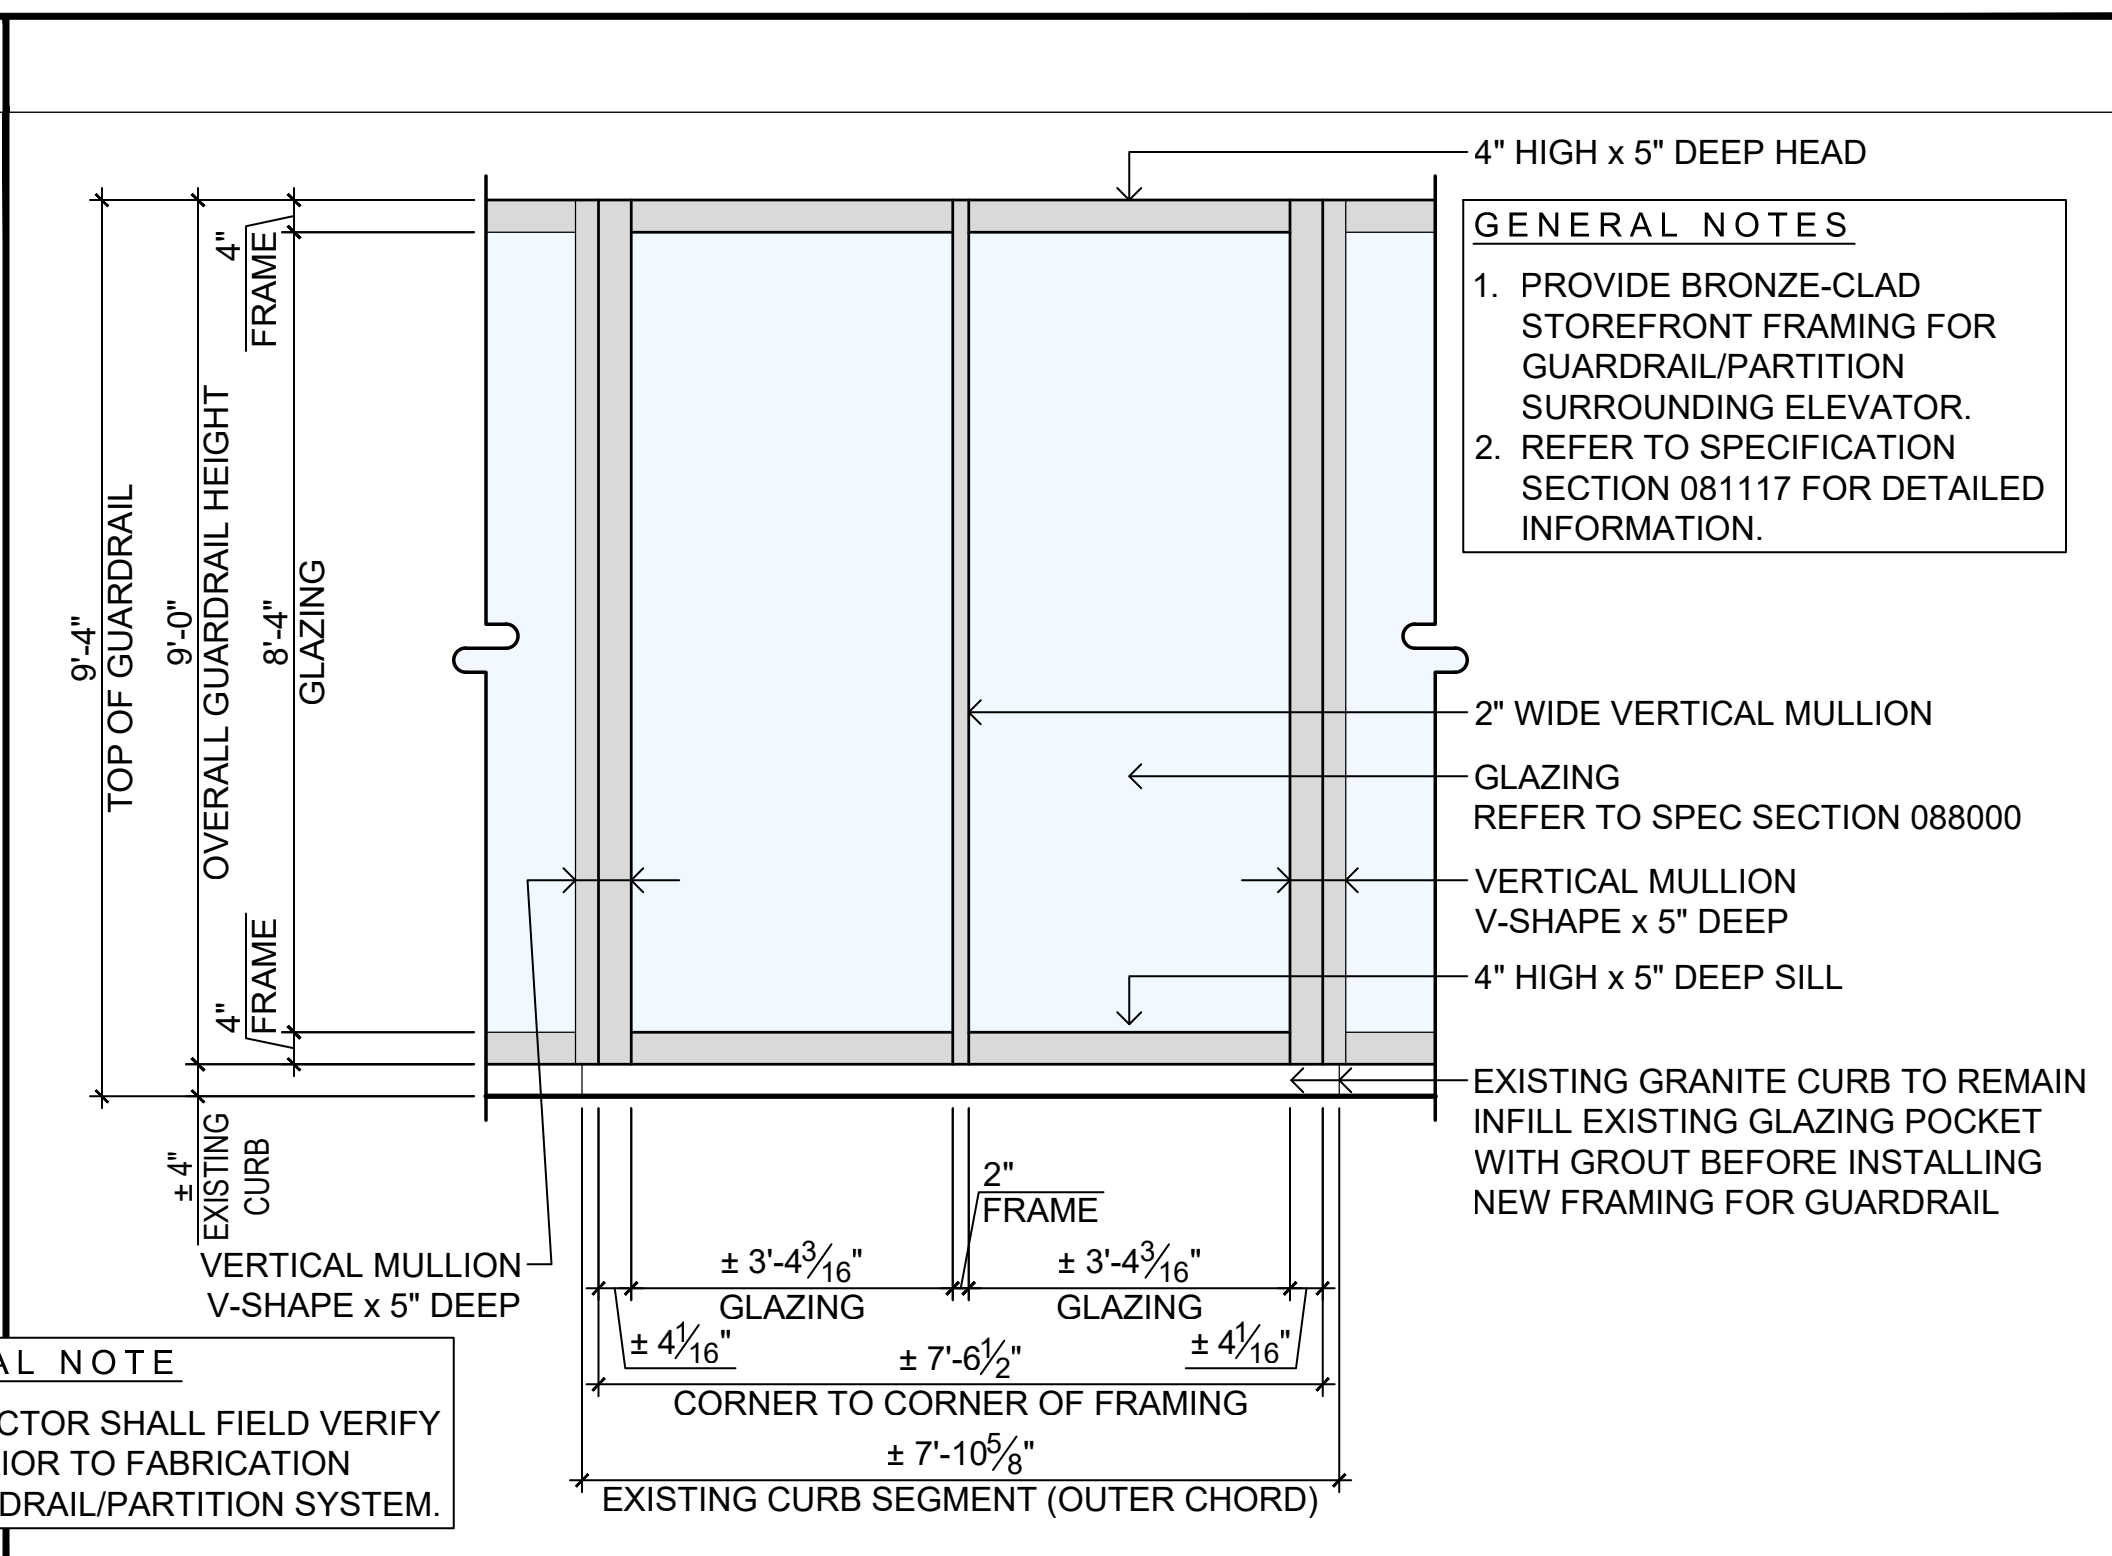


SCALE 1/2" = 1'-0"
ELEVATION OF ELEVATOR GUARDRAIL SEGMENT 02 (CENTER REAR) **04**

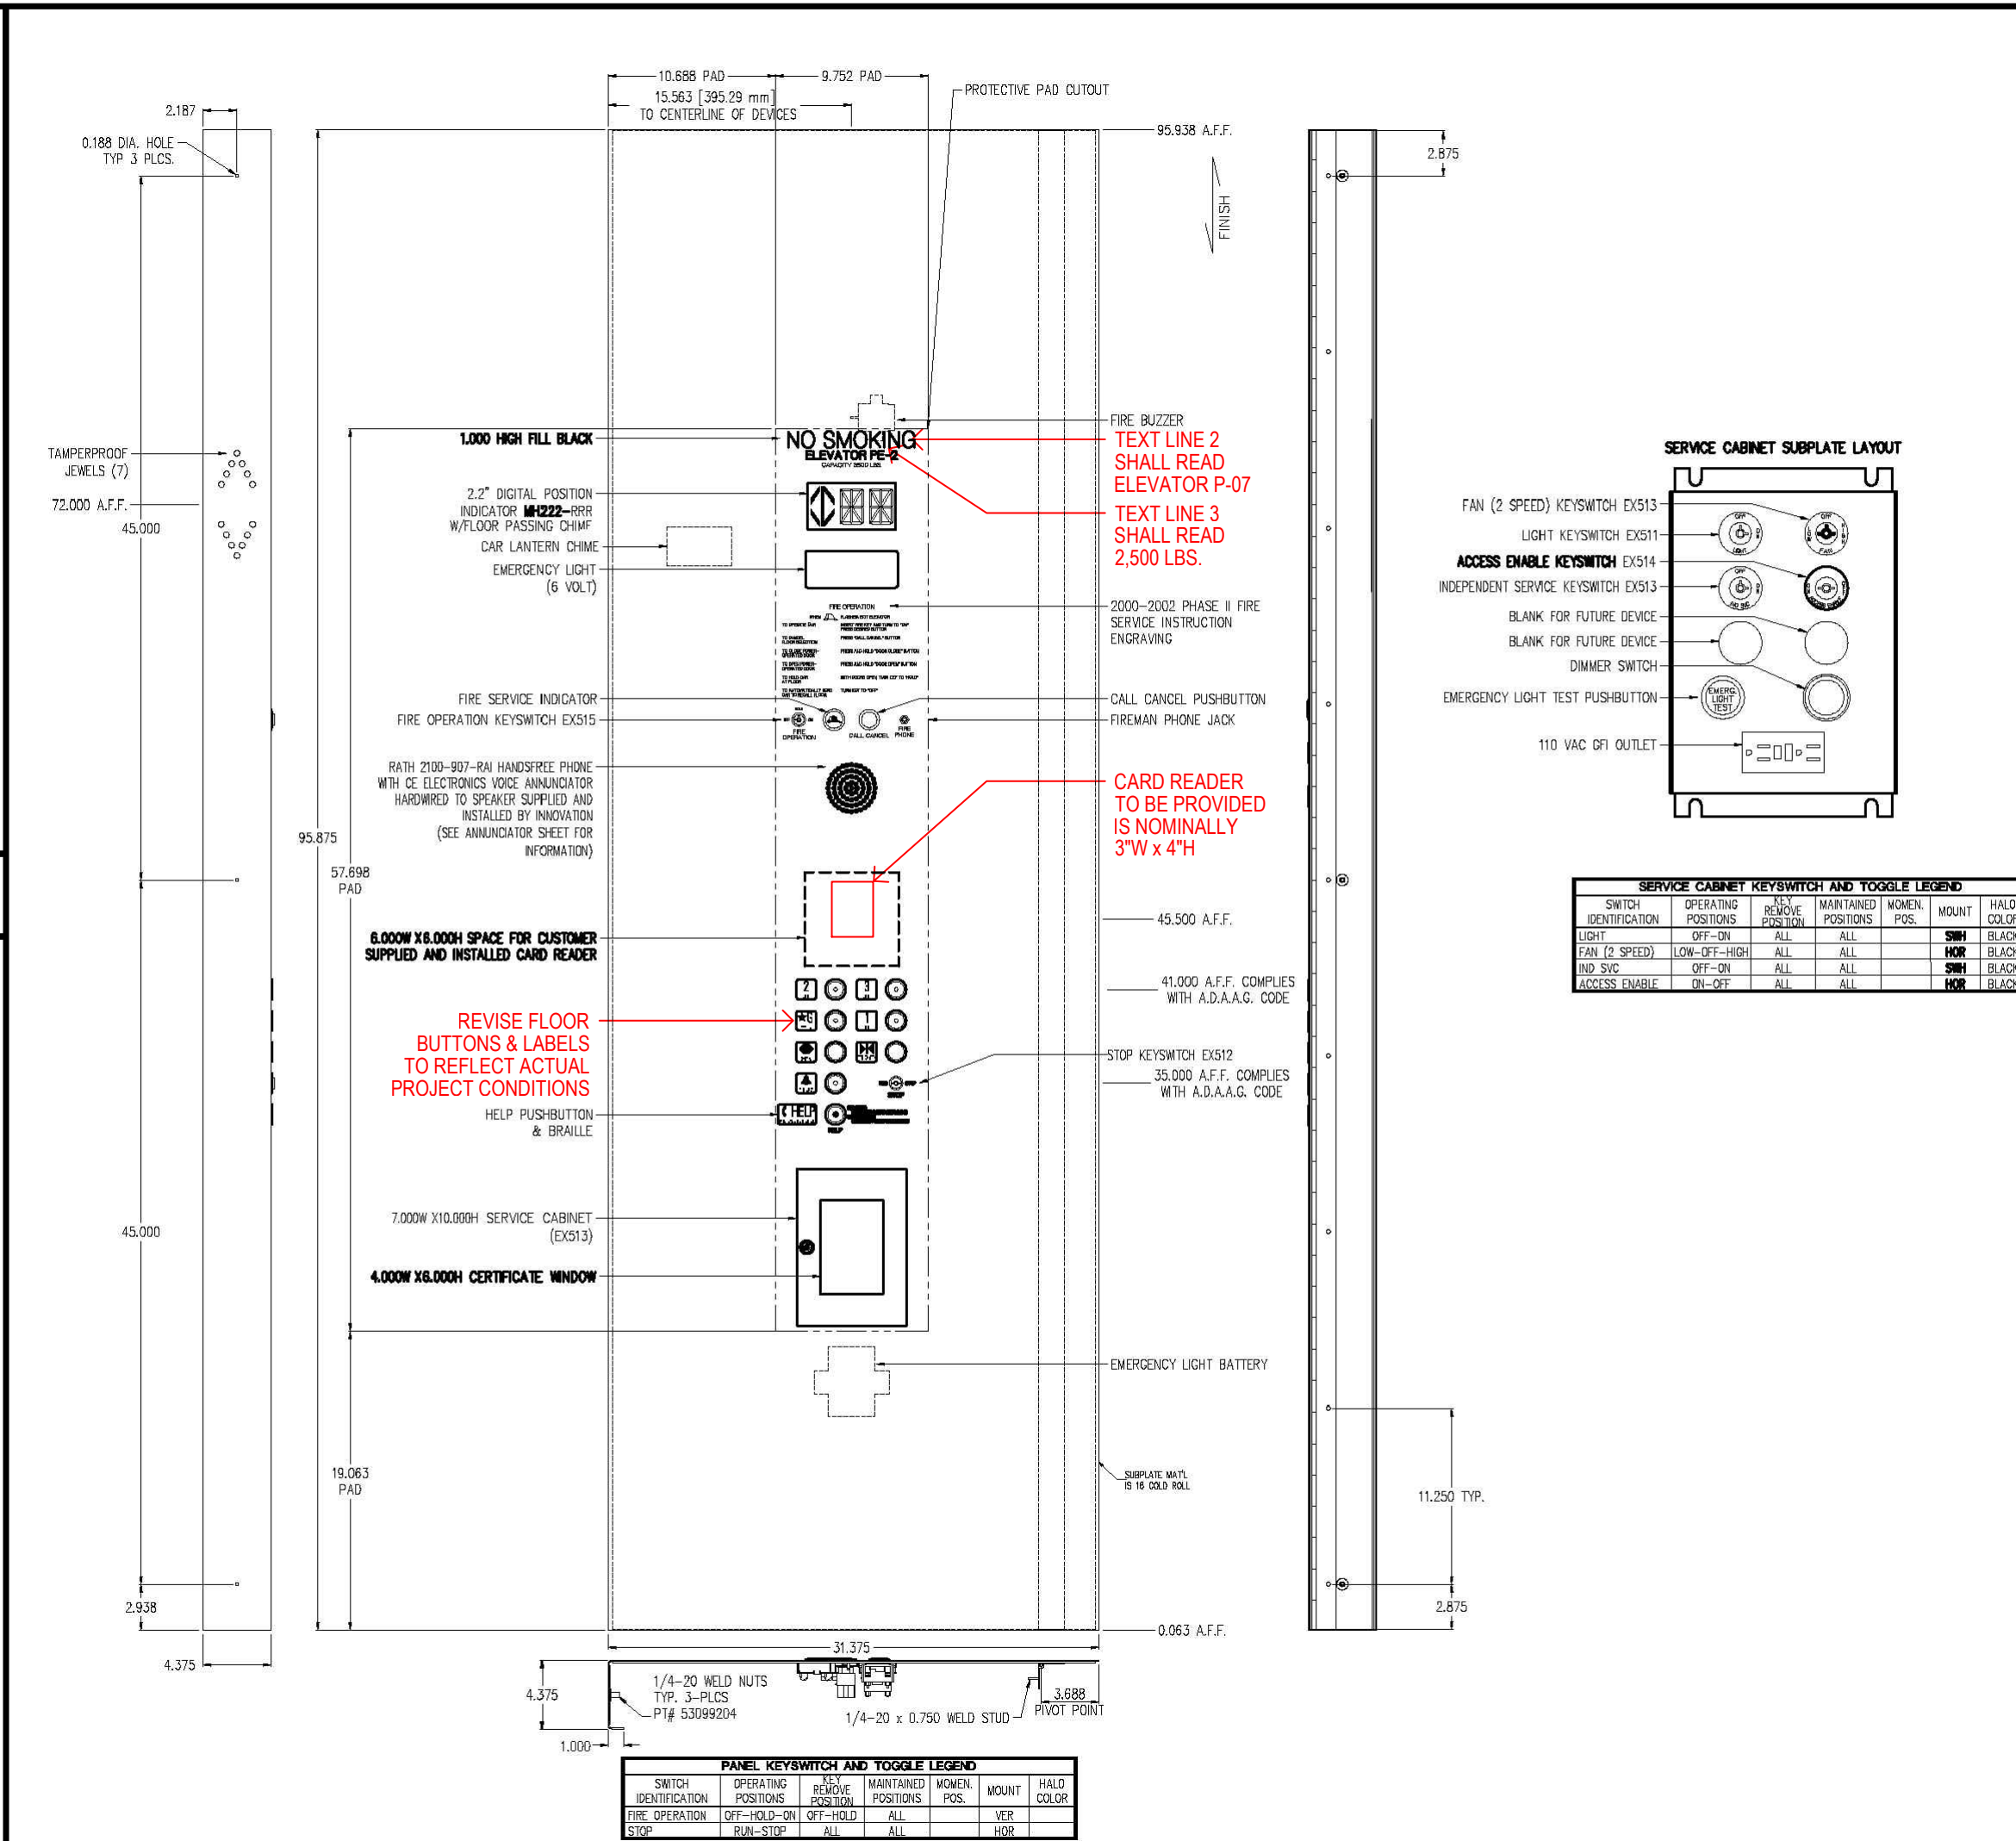

GENERAL NOTE
1. DETAIL ABOVE IS A MANUFACTURER'S STANDARD AND MAY REQUIRE ADJUSTMENTS TO COORDINATE WITH EXISTING CONDITIONS.
2. HALL STATIONS SHALL COMPLY WITH ACCESSIBILITY REQUIREMENTS.
3. REFER TO SPECIFICATIONS SECTION 142001, HYDRAULIC ELEVATORS, FOR ADDITIONAL INFORMATION.

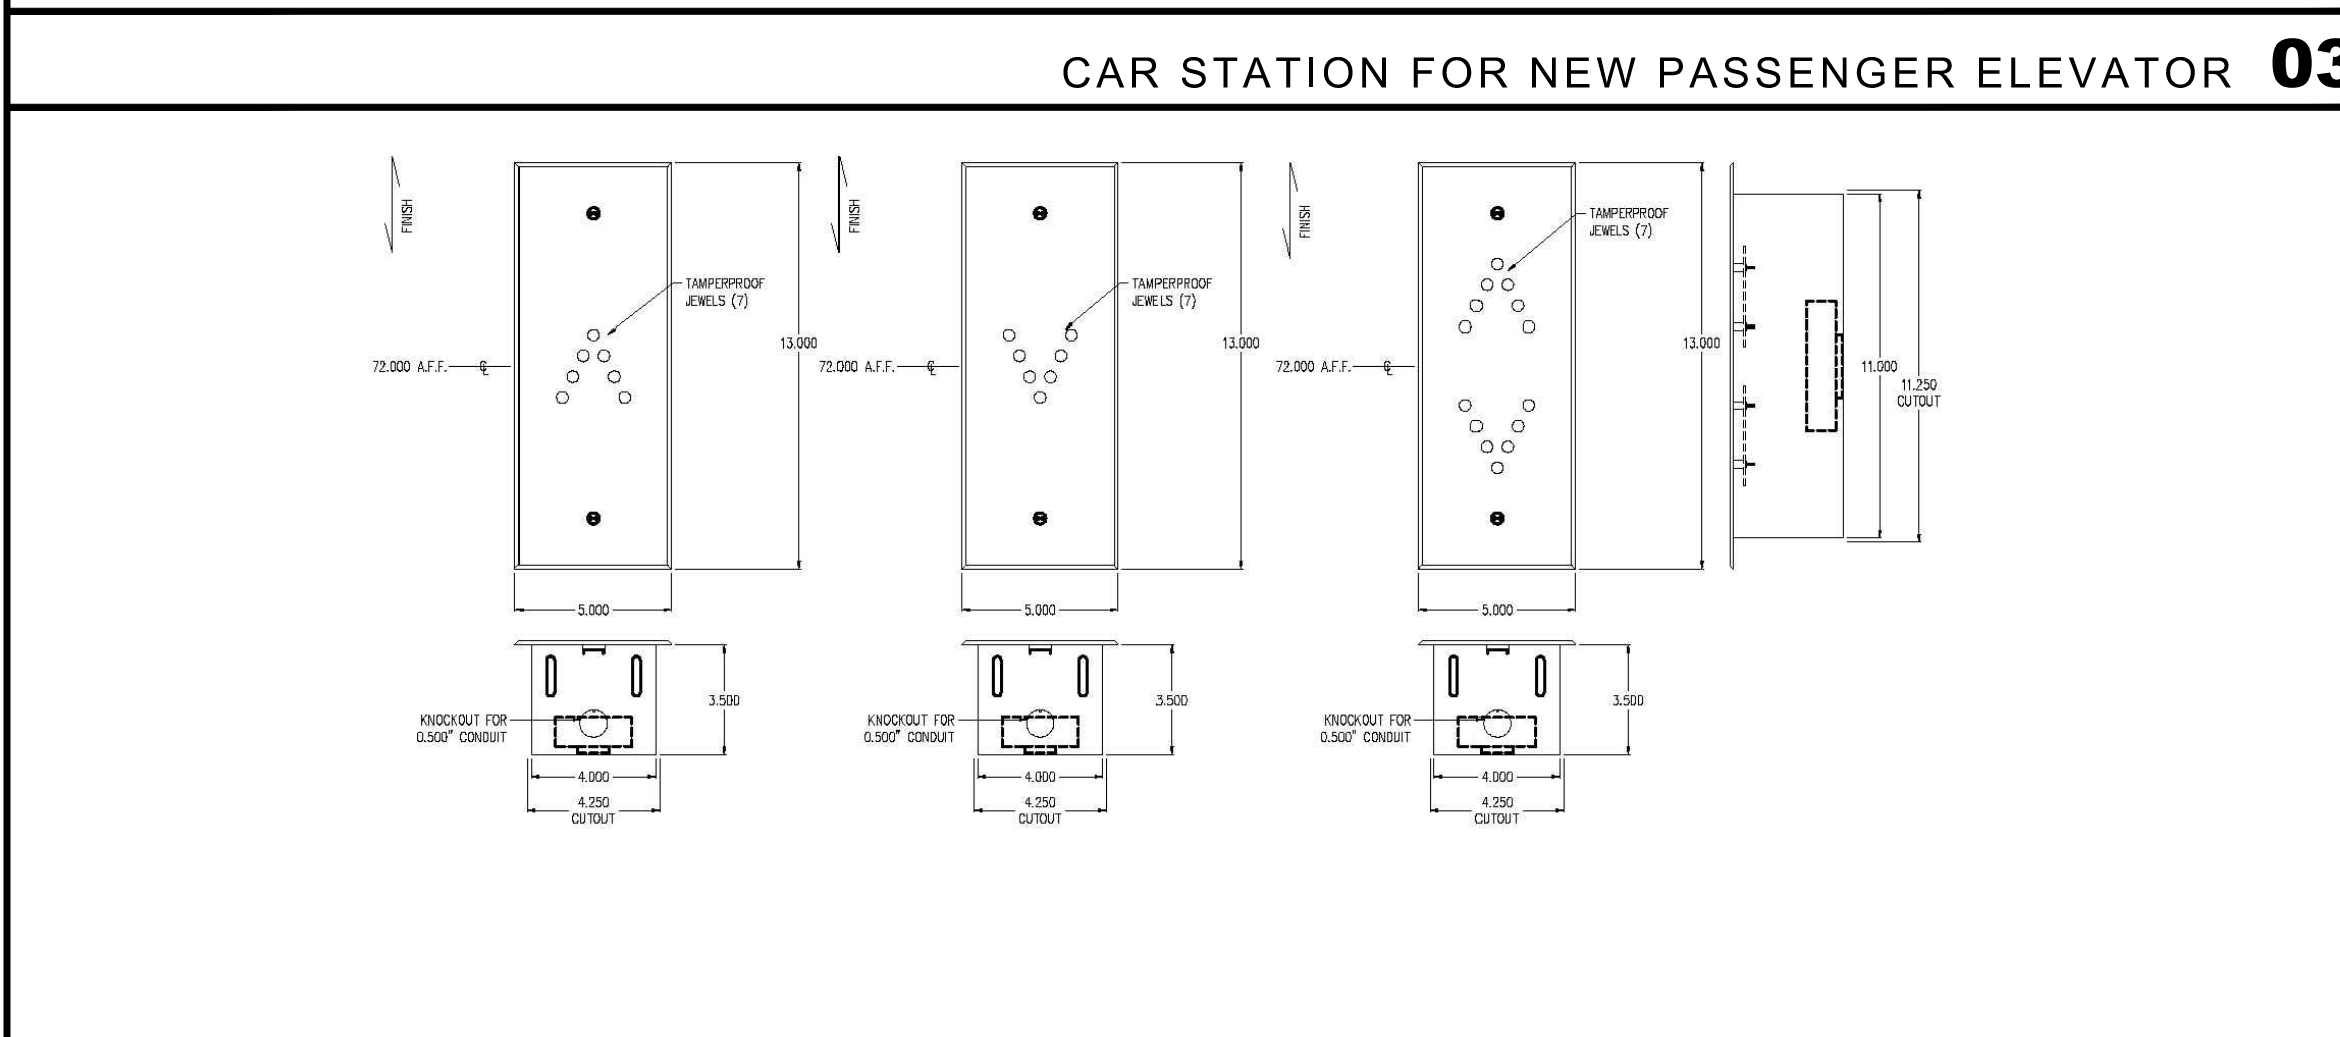

GENERAL NOTE
1. DETAIL ABOVE IS A MANUFACTURER'S STANDARD AND MAY REQUIRE ADJUSTMENTS TO COORDINATE WITH EXISTING CONDITIONS.
2. HALL STATIONS SHALL COMPLY WITH ACCESSIBILITY REQUIREMENTS.
3. REFER TO SPECIFICATIONS SECTION 142001, HYDRAULIC ELEVATORS, FOR ADDITIONAL INFORMATION.

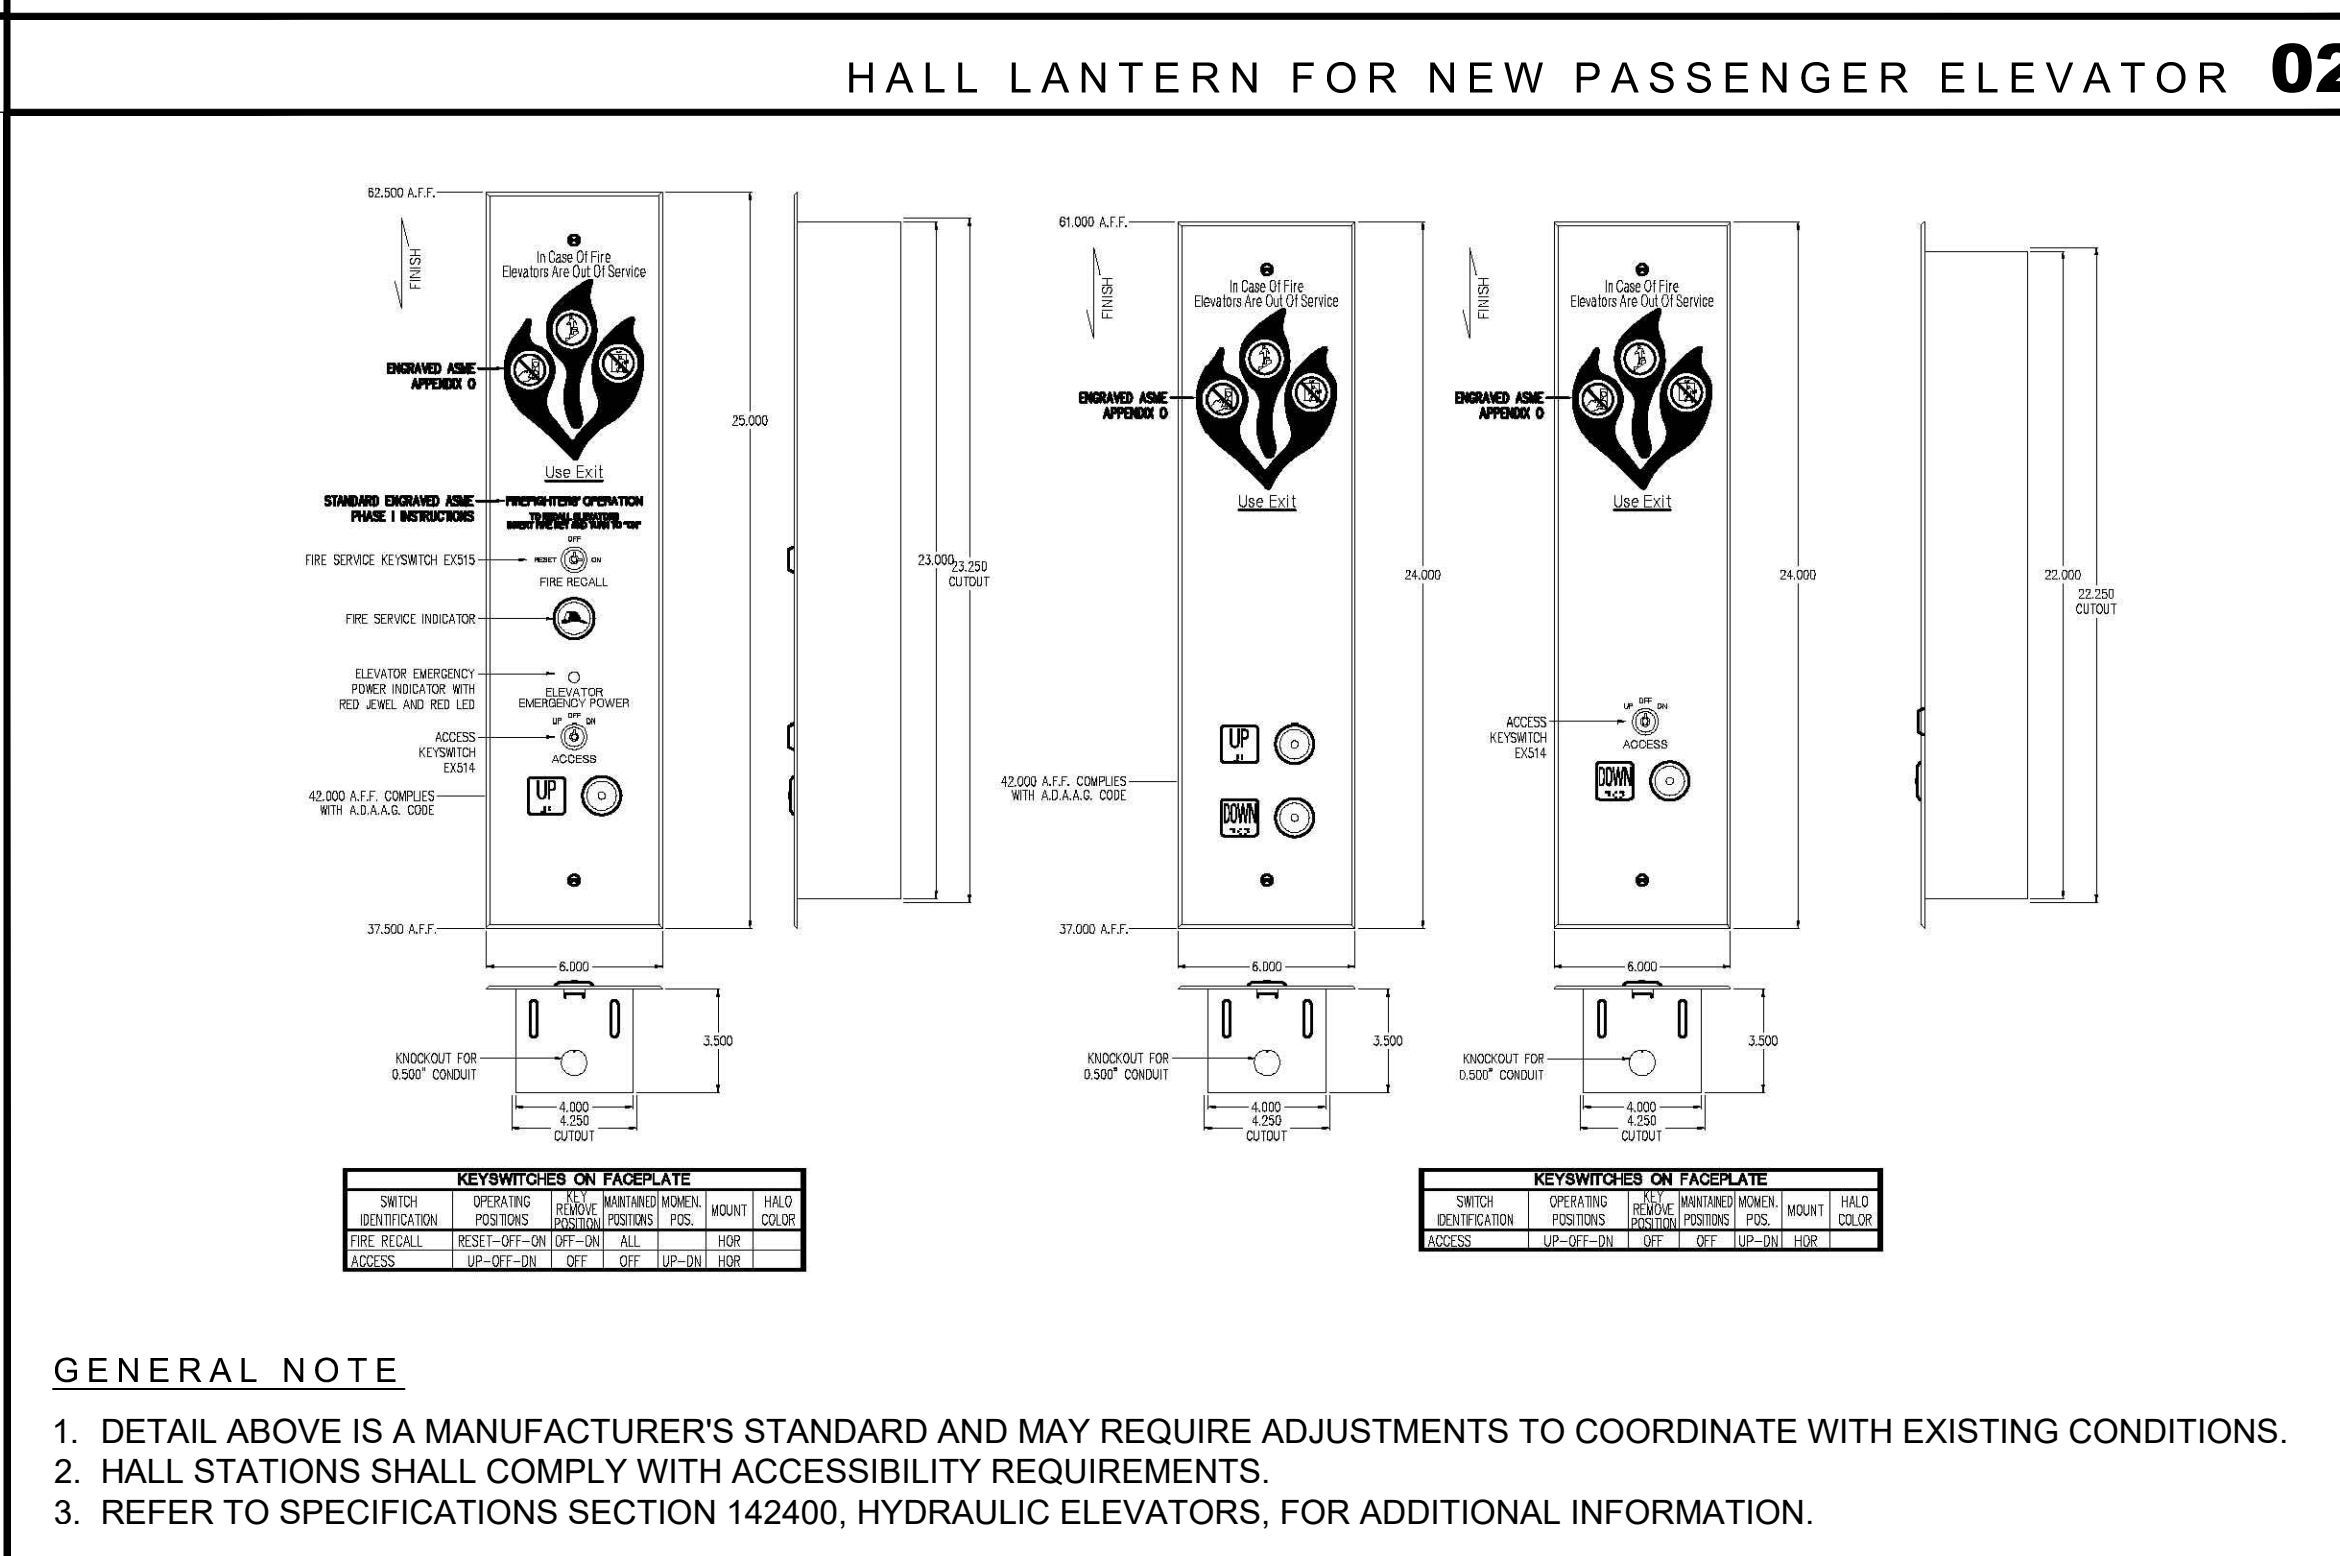

NEW HALL STATION FOR NEW PASSENGER ELEVATOR **01**

SCALE & DIMENSIONS	BASE BIDS
BAR IS ONE (1) INCH LONG ON ORIGINAL DRAWING 0 1 IF BAR IS NOT ONE (1) INCH LONG, ADJUST SCALE ACCORDINGLY. CONTRACTOR SHALL FIELD VERIFY ALL DIMENSIONS. VARIANCE FROM CONTRACT NOT PERMITTED WITHOUT BUREAU OF ENGINEERING AND ARCHITECTURE APPROVAL.	ALL WORK SHOWN ON THIS DRAWING IS INCLUDED IN BASE BID 01, UNLESS NOTED OTHERWISE ON THIS DRAWING. REFER TO PROJECT MANUAL FOR FULL DESCRIPTION OF ALL BASE BIDS.

CAR STATION FOR NEW PASSENGER ELEVATOR 03	
VITETTA PROJECT 4645.0000 © 2024 VITETTA ALL DIMENSIONS MUST BE VERIFIED BY THE CONTRACTOR AND THE ARCHITECT NOTIFIED OF ANY DISCREPANCIES BEFORE PROCEEDING WITH THE CONSTRUCTION TO AVOID SCALE THIS DRAWING.	
19	20
17	18
15	16
13	14
11	12
09	10
07	08
05	06
03	04
01	02
No.	DESCRIPTION
AS-BUILT REVISIONS	

VITETTA PROJECT 4645.0000 © 2024 VITETTA
ALL DIMENSIONS MUST BE VERIFIED BY THE CONTRACTOR AND THE ARCHITECT NOTIFIED OF ANY DISCREPANCIES BEFORE PROCEEDING WITH THE CONSTRUCTION TO AVOID SCALE THIS DRAWING.

19	20
17	18
15	16
13	14
11	12
09	10
07	08
05	06
03	04
01	02
No.	DESCRIPTION

AS-BUILT REVISIONS

VITETTA Professional's Signature
CONSULTANT
VITETTA
ARCHITECTURE | ENGINEERING | PLANNING
HISTORIC PRESERVATION
645 NORTH 12TH STREET • SUITE 100
LEMOYNE • PENNSYLVANIA • 17043
COMMONWEALTH OF PENNSYLVANIA
DEPARTMENT OF GENERAL SERVICES
HARRISBURG, PENNSYLVANIA
DGS PROJECT NUMBER
C-0948-0101 PHASE 001
CAPITOL EAST WING
REPLACEMENT OF ESCALATORS WITH ELEVATOR
HVAC DIFFUSERS & CAFETERIA UPGRADES
HARRISBURG, DAUPHIN COUNTY, PENNSYLVANIA
NEW PASSENGER ELEVATOR
AND GUARDRAIL
MISCELLANEOUS DETAILS
DRAWN BY
J. JOLIN
DATE
01.04.2024
DRAWING NUMBER
A414
CHECKED BY
D. VOZDZAK
SCALE
AS NOTED