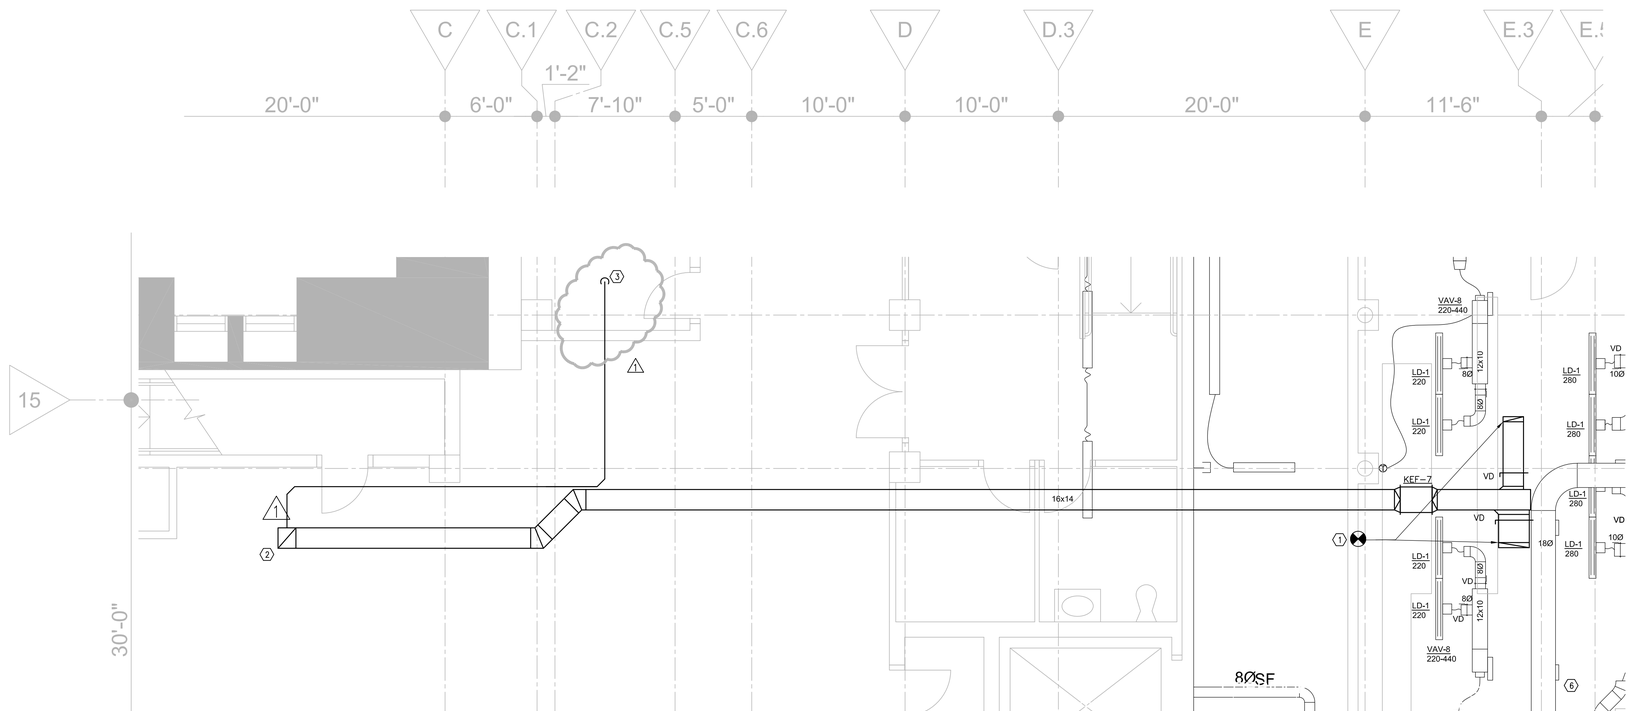

KEY NOTES

1. CONNECT TO EXISTING DISHWASHER EXHAUST HOOD AT FULL SIZE OF CONNECTIONS.
2. CONNECT TO NEW FITTING SHOWN ON A601.
3. DISCHARGE DRAIN INTO EXISTING FLOOR DRAIN IN MECHANICAL ROOM.

C / H-201C AREA C MECHANICAL PLAN

SCALE & DIMENSIONS	BASE BIDS
BAR IS ONE (1) INCH LONG ON ORIGINAL DRAWING 0 — 1 IF BAR IS NOT ONE (1) INCH LONG, ADJUST SCALE ACCORDINGLY. CONTRACTOR SHALL FIELD VERIFY ALL DIMENSIONS. VARIANCE FROM CONTRACT NOT PERMITTED WITHOUT BUREAU OF ENGINEERING AND ARCHITECTURE APPROVAL.	ALL WORK SHOWN ON THIS DRAWING IS INCLUDED IN BASE BID 02, UNLESS NOTED OTHERWISE ON THIS DRAWING. REFER TO PROJECT MANUAL FOR FULL DESCRIPTION OF ALL BASE BIDS.

BUILDING KEY PLAN

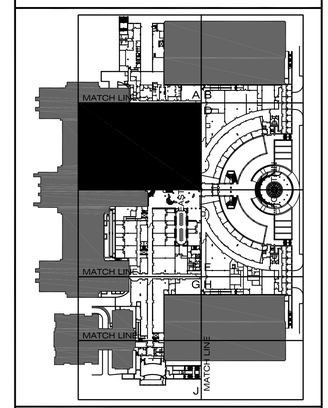

VITETTA PROJECT 4645.0000

© 2023 VITETTA

ALL DIMENSIONS MUST BE VERIFIED BY CONTRACTOR AND THE ARCHITECT NOTIFIED OF ANY DISCREPANCIES BEFORE PROCEEDING WITH THE CONSTRUCTION

DO NOT SCALE DRAWINGS

No.	DESCRIPTION	No.	DESCRIPTION
19		20	
17		18	
15		16	
13		14	
11		12	
09		10	
07		08	
05		06	
03		04	
01	1 ADDENDUM 1	02	

AS-BUILT REVISIONS

1-4-2024

COMMONWEALTH OF PENNSYLVANIA REGISTERED PROFESSIONAL MICHAEL A. WEIGAND ENGINEER 042290-E

VITETTA Professional's Signature

01.04.2024

Consultant Professional's Signature Date

CONSULTANT

VITETTA
ARCHITECTURE | ENGINEERING | PLANNING
HISTORIC PRESERVATION
645 NORTH 12TH STREET • SUITE 100
LEMOYNE • PENNSYLVANIA • 17043

WAI HPE Consulting Engineers
WEIGAND ASSOCIATES, INC.
20270 GOLDENROD LANE • SUITE 100
GERMANTOWN • MARYLAND • 20876

COMMONWEALTH OF PENNSYLVANIA
DEPARTMENT OF GENERAL SERVICES
HARRISBURG, PENNSYLVANIA

DGS PROJECT NUMBER
C-0948-0101 PHASE 001

CAPITOL EAST WING
REPLACEMENT OF ESCALATORS WITH ELEVATOR, HVAC DIFFUSERS, AND CAFETERIA UPGRADES

500 COMMONWEALTH AVENUE
HARRISBURG, DAUPHIN COUNTY, PENNSYLVANIA 17101

CONCOURSE - AREA C
MECHANICAL PLAN

DRAWN BY	DATE	DRAWING NUMBER
PAHNO	2.12.2024	H-201C-II
CHECKED BY	SCALE	
WEIGAND	1/4" = 1'-0"	

FILE PATH: P:\PROJECTS\23003 DGS-C-0948-0101 East Wing Cafeteria Upgrade\DWG\M-201C-II.dwg
LAST SAVED: 24.01.29 03:52 PM
PLOTTED: 24.01.29 04:02 PM
PLOTTED BY: PPAHNO

DRAWING SET IS INTENDED FOR COLOR PRINTING