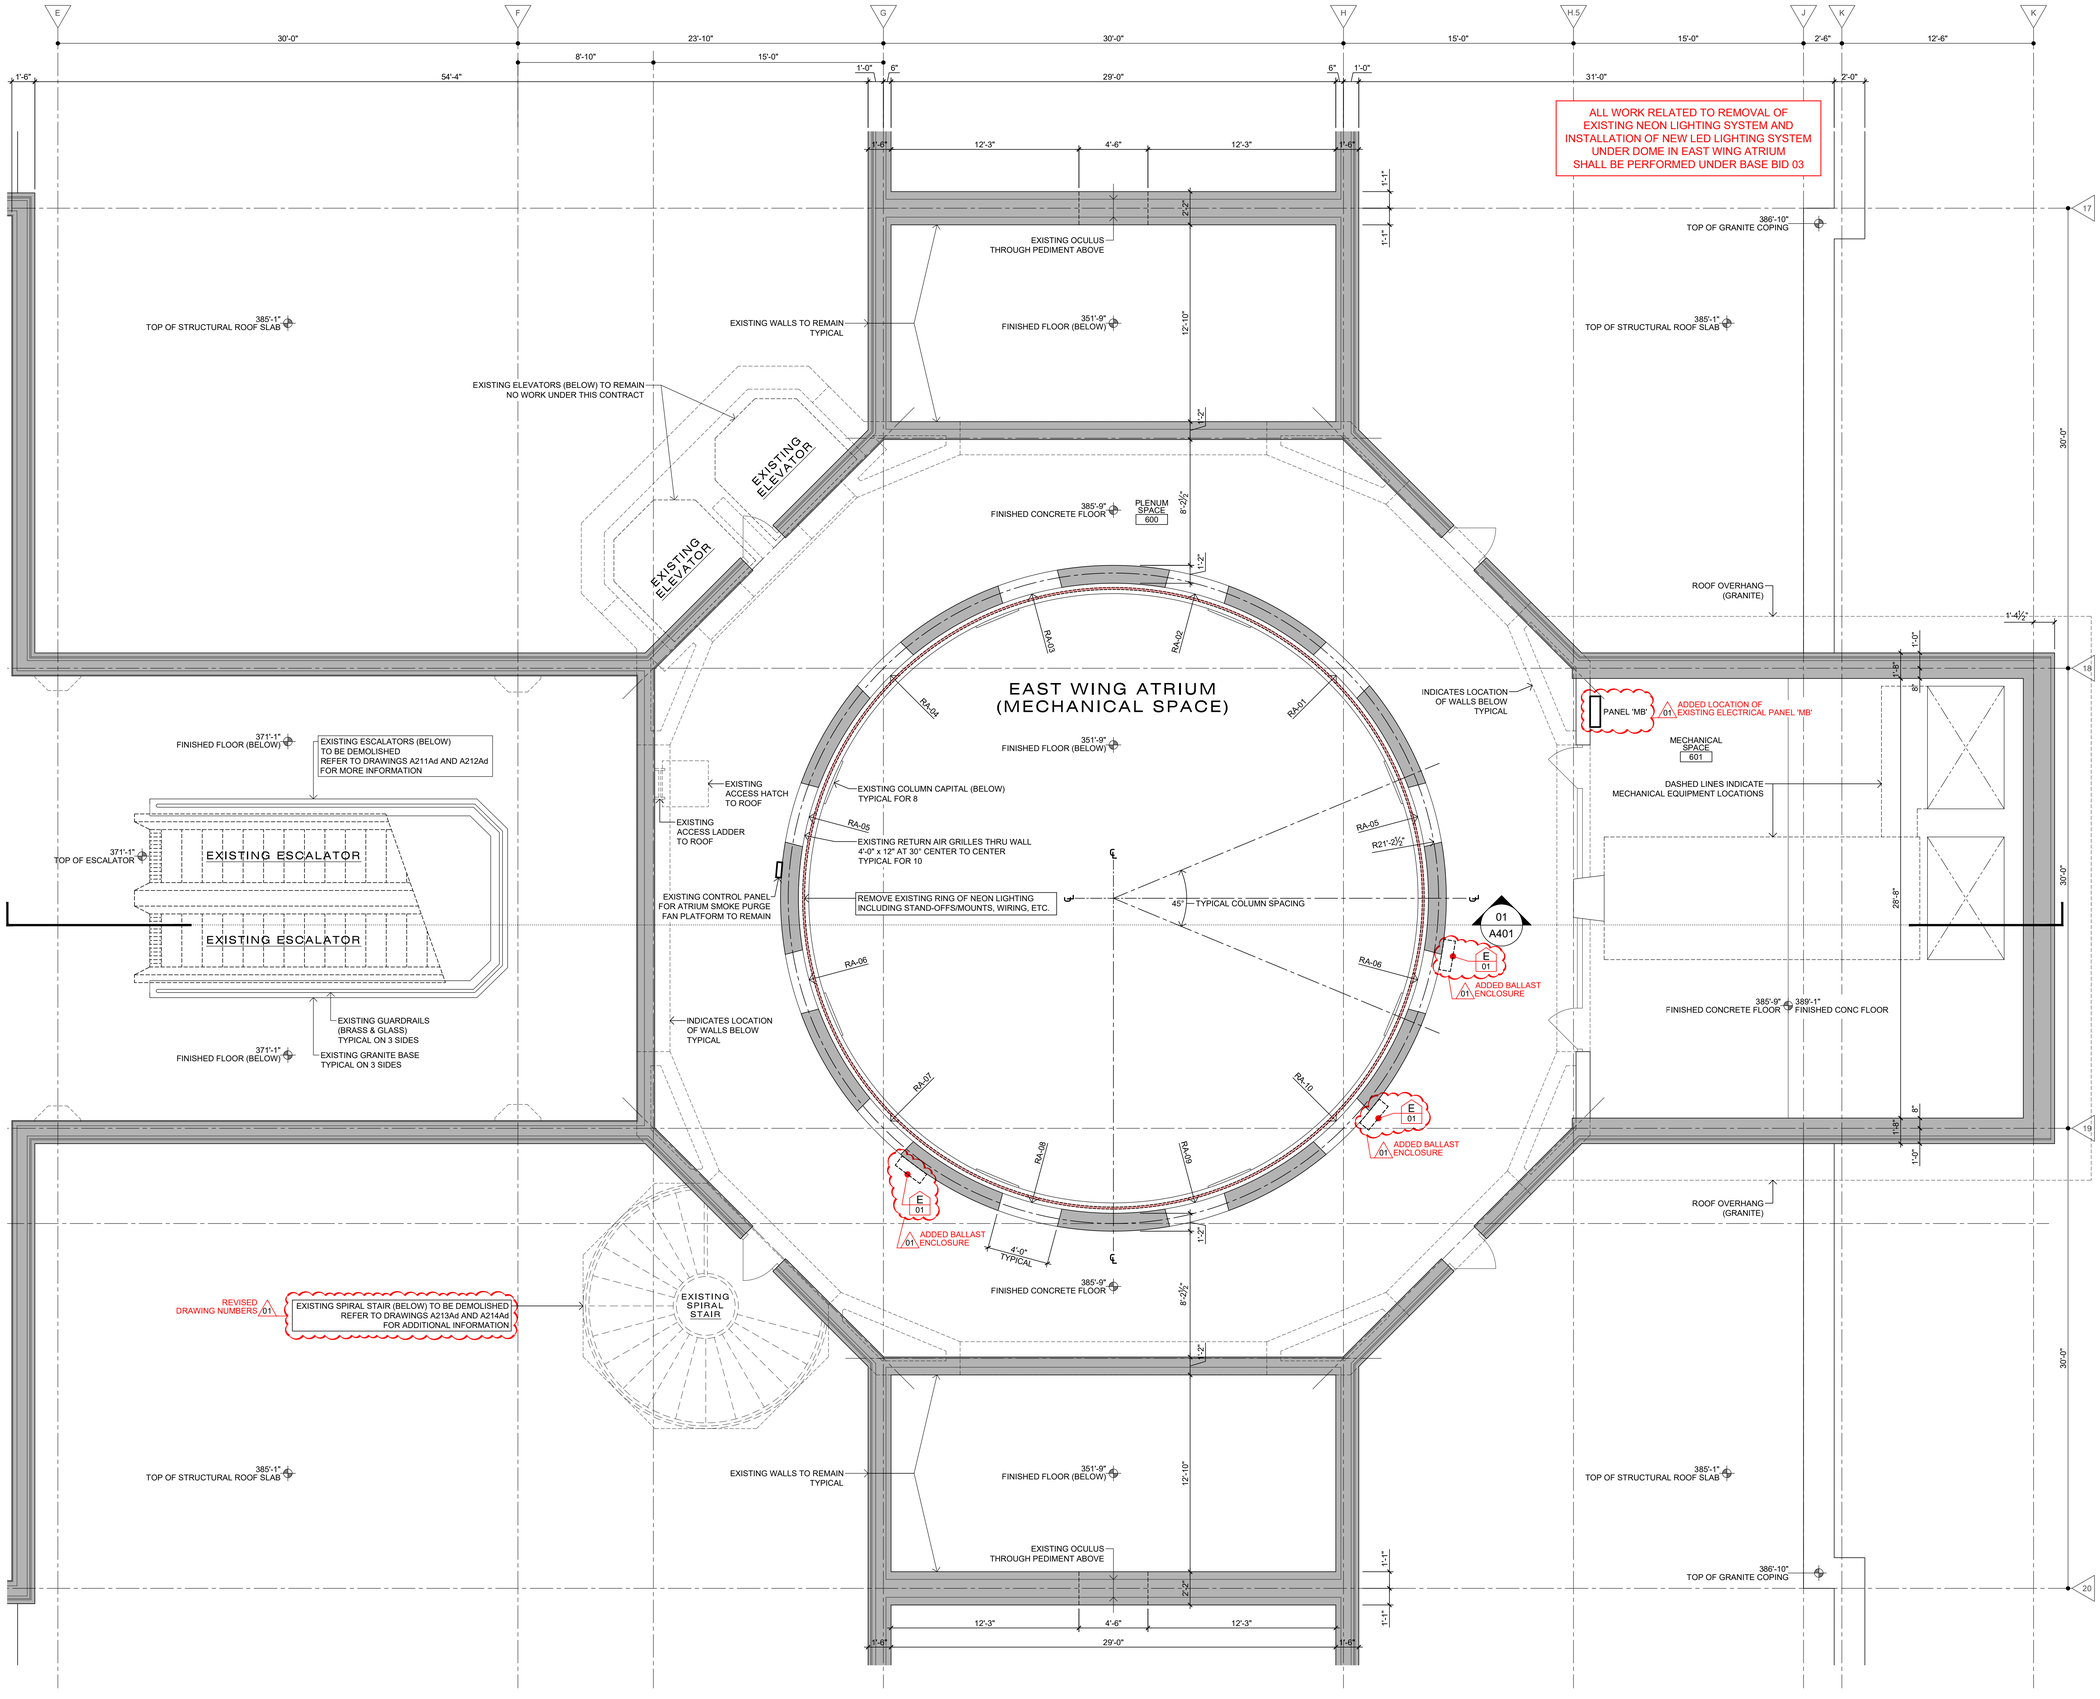

SCALE
1/4" = 1'-0"

MECHANICAL SPACE FLOOR PLAN (LEVEL 385'-9") - ATRIUM - LIGHTING FIXTURE REPLACEMENT - DEMOLITION **01**

SCALE & DIMENSIONS

BAR IS ONE (1) INCH LONG ON ORIGINAL DRAWING

0 1

IF BAR IS NOT ONE (1) INCH LONG, ADJUST SCALE ACCORDINGLY. CONTRACTOR SHALL FIELD VERIFY ALL DIMENSIONS. VARIANCE FROM CONTRACT NOT PERMITTED WITHOUT BUREAU OF ENGINEERING AND ARCHITECTURE APPROVAL.

BASE BIDS

ALL WORK SHOWN ON THIS DRAWING IS INCLUDED IN BASE BID 01, UNLESS NOTED OTHERWISE ON THIS DRAWING.

REFER TO PROJECT MANUAL FOR FULL DESCRIPTION OF ALL BASE BIDS.

BUILDING KEY PLAN

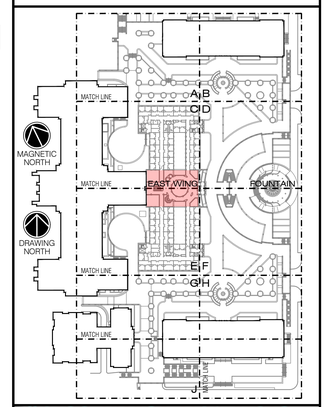

DEMOLITION KEY NOTES

E 01 — REMOVE EXISTING BALLAST ENCLOSURES (3 TOTAL) FOR THE FORMER NEON LIGHTING SYSTEM, WHICH ARE NOW ABANDONED AND EMPTY. REMOVE ASSOCIATED SWITCHES. REMOVE APPROXIMATELY 150 LF OF EXISTING 3/4" CONDUIT WITHIN PLENUM SPACE 600 AND APPROXIMATELY 140 LF OF CONDUIT INSIDE THE ATRIUM RING. PULL ALL WIRE FROM CONDUIT.

ADDED KEY NOTE E/01

VITETTA PROJECT 4645.0000

© 2024 VITETTA

ALL DIMENSIONS MUST BE VERIFIED BY THE CONTRACTOR(S) AND THE ARCHITECT NOTIFIED OF ANY DISCREPANCIES BEFORE PROCEEDING WITH THE CONSTRUCTION

DO NOT SCALE THIS DRAWING

No.	DESCRIPTION	No.	DESCRIPTION
19		20	
17		18	
15		16	
13		14	
11		12	
09		10	
07		08	
05		06	
03		04	
01	ADDENDUM 01 | 00.00.2024	02	

AS-BUILT REVISIONS

REGISTERED ARCHITECT PENNSYLVANIA DANIEL R. VODZAK, III, P.A.

02.12.2024

VITETTA Professional's Signature — Consultant Professional's Signature — Date

CONSULTANT
VITETTA
ARCHITECTURE | ENGINEERING | PLANNING
HISTORIC PRESERVATION
645 NORTH 12TH STREET • SUITE 100
LEMOYNE • PENNSYLVANIA • 17043

COMMONWEALTH OF PENNSYLVANIA
DEPARTMENT OF GENERAL SERVICES
HARRISBURG, PENNSYLVANIA

DGS PROJECT NUMBER
C-0948-0101 PHASE 001

CAPITOL EAST WING
REPLACEMENT OF ESCALATORS WITH ELEVATOR
HVAC DIFFUSERS & CAFETERIA UPGRADES

HARRISBURG, DAUPHIN COUNTY, PENNSYLVANIA

MECHANICAL SPACE
ATRIUM
ELECTRICAL DEMOLITION PLAN

DRAWN BY	DATE	DRAWING NUMBER
J. JOLIN	BID SET ISSUED 01.04.2024	E215Ad
CHECKED BY D. VODZAK	SCALE 3/8" = 1'-0"	

FILE PATH: P:\Projects\4645_00\ELEC\4645_E215Ad_Level-6-Atrium-Mech_Enlarged_DEMO_ELEC.dwg
LAST SAVED: 24.02.08 04:46 PM — PLOTTED: 24.02.13 12:30 PM — PLOTTED BY: JOLIN

DRAWING IS INTENDED FOR COLOR PRINTING